
Form 51-10M-7-20-CroMac

Map No. K 23 Sec. 9 Twp. 22 R. 4

Well No. 12 Jolliffe Farm

Watchorn et al Company

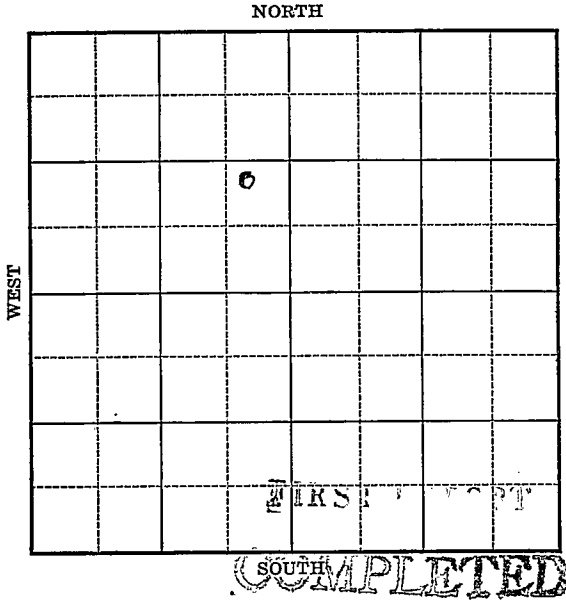

6

Location _____

Drilling Remarks:

Rig Up _____

Drilling Remarks:

RECORD

Cased _____ in. _____ ft.

Sand _____

Gas _____

Oil _____

Total Depth _____

PRODUCTION

1st 24 hrs. Nat. _____

1st 24 hrs. after shot _____

Gas _____ cu. ft.

Dry Hole _____

Abandoned _____

Form 252A—6M-3-20-CroMac

Map No. N. 23 Sec. 8 Twp. 22 R. 4

Well No. 12 J. Cliffe Farm


Walkover Ext. Co. Company

_____ Ft. from N. Line

1120 Ft. from S. Line

600 Ft. srom E. Line

_____ Ft from W. Line

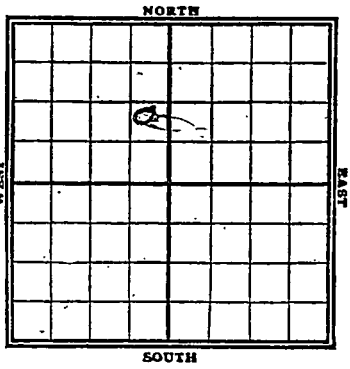

1920	REPORT
8/9	Rig Up.
16	Drlg.
8/23	Drlg on.
8/31	Dly @ 500
9/2	" 1335
20	" 1575'
27	Dly @ 1910'
10/28	2514-16 - 150 bbls.


R 23

State _____ County _____

Sec. 9 Twp. 22 N-S. Rge. 4 E-W

Well No. 12 Jolliffe Farm

Watchorn et al Company

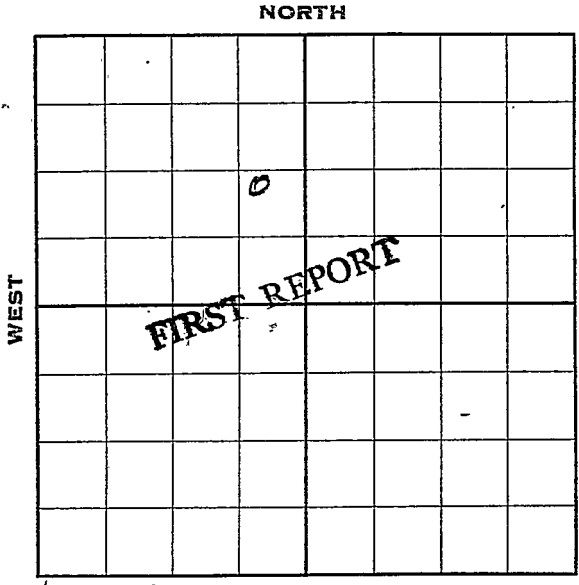

600 E 1120 S

Location _____

Rig up ✓ Mach. _____

Drilling at _____

Fishing at _____

U. R. to _____

S. D. at _____

Cased _____ in. _____ ft.

Productive Horizons

From	To

Natural production _____ Bbls. per _____ hours

Pumping _____ Gas _____ Cu. ft. per 24 hours

Gauge press. _____ lbs. Total depth _____

Were samples collected _____

Remarks:

8/9 19 20 Pyle Scout

S. C. 9-1M-11-19. 29023

(Over)

Form 26—1M—4-19—Mid-West


Map No. K23 Sec. 9 Twp. 22 R. 4E

Well No. 12 Gollihue

Hatchard et al Company

Contractor

SECTION PLAT

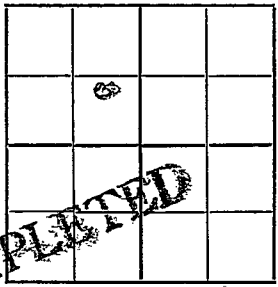

1120 Ft. from S. Line

600 Ft. from E. Line

Ft. from N. Line

Ft. from W. Line

COMPLETED

Location

Rig up

Drilling and Remarks:

RECORD

Cased in. ft.

Sand 25M-16

Gas

Oil

Total Depth

PRODUCTION

1st 24 hrs. Nat. 150 bbls

1st 24 hrs. after shot

Gas Cu. Ft.

Dry Hole

Abandoned

Date

10/28/1920

Pyle Scout