

Sec. 9 Twp. 22 Range 4E

#1 Joffe

Kansas Geological Society

Crawford, et al.


Skelly Scout Tickets

Map No. _____ Sec. 9 Twp. 22 R. 2
 Well No. 145 Jaffee Farm
Crawford et al Company

NORTH

WEST

EAST

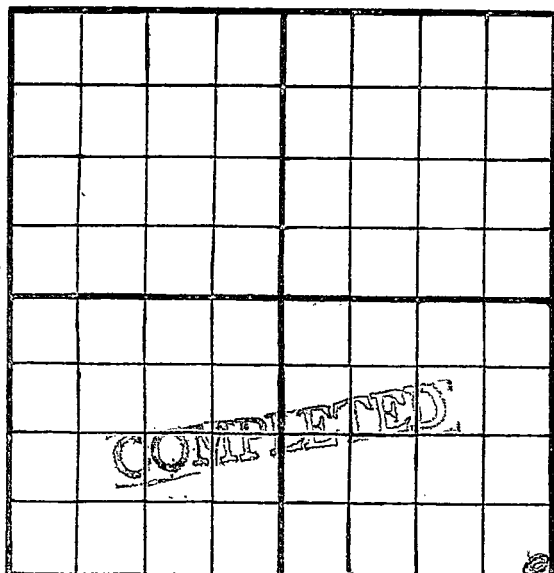

SOUTH

Location _____

Rig Up _____

Drilling Remarks: _____

Drilling Remarks: _____

RECORD

Cased _____ in. _____ ft.

Sand _____

Gas _____

Oil _____

Total Depth _____

PRODUCTION

1st 24 hrs. Nat. _____

1st 24 h's. after shot _____

Gas _____ cu. ft

Dry Hole _____

Abandoned _____

Map No. K23 Sec. 9 Twp. 22 R. 4Well No. 1 ValleyCrawford et al Company

Contractor

NORTH

WEST

EAST

COMPLETED

SOUTH

Location 250 S 1/2 E

Rig up

Drilling and Remarks:

pumping
12 bbls daily
80% water

RECORD

Cased _____ in., _____ ft.

Sand 2505-2506

Gas _____

Oil _____

Total Depth _____

PRODUCTION

1st 24 hrs. Nat. _____

1st 24 hrs. after shot _____

Gas _____ Cu. Ft.

Dry Hole _____

Abandoned _____

Date

10/9
1918

1918

C. J. W.
Scout

Scout

Map No. 162 Sec. 9 Twp. 22 R. 7

Well No. 1145 Farm _____

Company

NORTH

WEST

EAST

FIRST REPORT

SOUTH

Location _____

Rig Up ☒

Drilling and remarks

RECORD

Cased_____ in_____Ft.

Sand -----

Gas -----

Oil _____

Total Depth -----

PRODUCTION

1st 24 hrs. Nat. _____

1st 24 hrs. after shot-----

Gas ----- Cu. Ft.

Dry Hole _____

Abandoned -----


1ST REPORT

Date _____

191

Scout

Map No. _____ Sec. 9 Twp. 22 R. 4
 Well No. 1 Golden
Crawford et al Company
 _____ Contractor

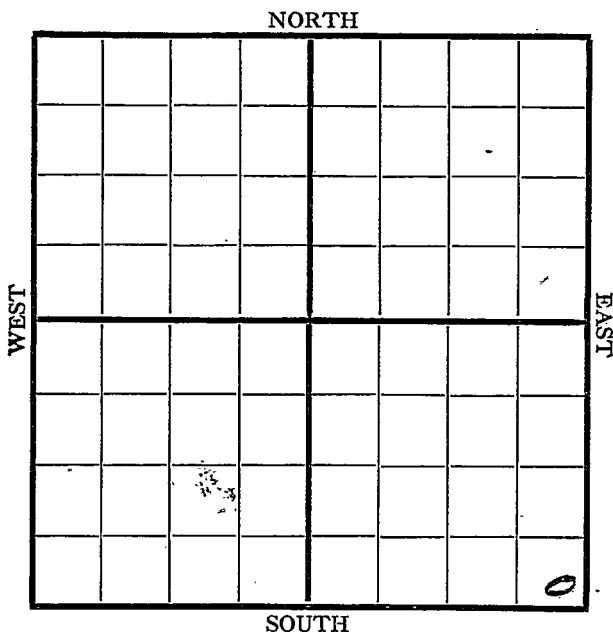

Location _____
 Rig up _____
 Drilling and Remarks:

D. D. C.
2200

RECORD

Cased _____ in., _____ ft.
 Sand _____
 Gas _____
 Oil _____
 Total Depth _____

PRODUCTION

1st 24 hrs. Nat. _____
 1st 24 hrs. after shot _____
 Gas _____ Cu. Ft.
 Dry Hole _____
 Abandoned _____

Date 7/2/1918 Cyle Scout

Map No. _____ Sec. 9 Twp. 22 R. 4Well No. 1 Gallop
Crawford et al Company _____

Contractor _____

NORTH

WEST

EAST

SOUTH

Location _____

Rig up _____

Drilling and Remarks:

*2.10 for
money @
2200'*

RECORD

Cased _____ in., _____ ft.

Sand _____

Gas _____

Oil _____

Total Depth _____

PRODUCTION

1st 24 hrs. Nat. _____

1st 24 hrs. after shot _____

Gas _____ Cu. Ft.

Dry Hole _____

Abandoned _____

Date

7/19 1918

J. H. Scout

Map No. _____ Sec. 9 Twp. 22 R. 4Well No. 1 GalenaCrawford et al Company

Contractor _____

NORTH

WEST

EAST

SOUTH

Location 250 ftRig up 250 ft

Drilling and Remarks:

fishing
casing @2200'

RECORD

Cased _____ in., _____ ft.

Sand _____

Gas _____

Oil _____

Total Depth _____

PRODUCTION

1st 24 hrs. Nat. _____

1st 24 hrs. after shot _____

Gas _____ Cu. Ft.

Dry Hole _____

Abandoned _____

Date

8/1 1918 C. G. L. Scout


Map No. _____ Sec. 9 Twp. 22 R. 4Well No. 1 GalfinCrawford et al Company

Contractor _____

NORTH

WEST

EAST

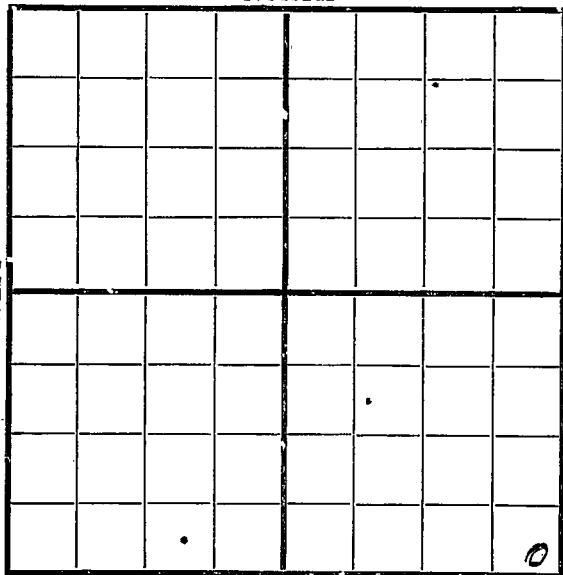

SOUTH

250 1/4 E

Location _____

Rig up _____

Drilling and Remarks:

D. 10 @
2200'

RECORD

Cased _____ in., _____ ft.

Sand _____

Gas _____

Oil _____

Total Depth _____

PRODUCTION

1st 24 hrs. Nat. _____

1st 24 hrs. after shot _____

Gas _____ Cu. Ft.

Dry Hole _____

Abandoned _____

Date

8/

191

8Cyke

Scout


Map No. _____ Sec. 9 Twp. 22 R. 4Well No. 1 JollyCrawford / et al Company

Contractor _____

NORTH

WEST

EAST

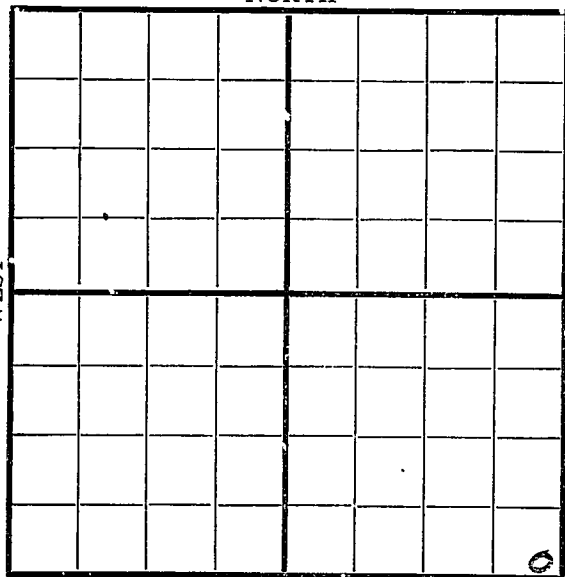

SOUTH

250 AFE

Location _____

Rig up _____

Drilling and Remarks:

D. V @2200'

RECORD

Cased _____ in., _____ ft.

Sand _____

Gas _____

Oil _____

Total Depth _____

PRODUCTION

1st 24 hrs. Nat. _____

1st 24 hrs. after shot _____

Gas _____ Cu. Ft.

Dry Hole _____


Abandoned _____

Date

8/141918Jolly

Scout

Map No. _____ Sec. 7 Twp. 22 R. 1
 Well No. 1
Crawford Oil Co. Company
 _____ Contractor

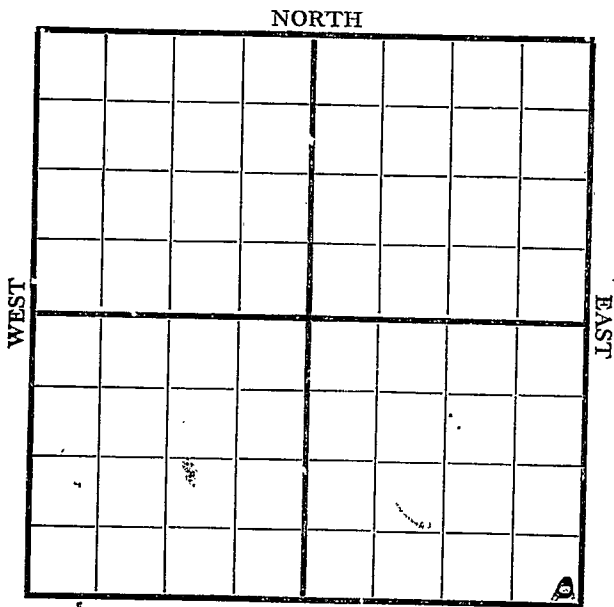

250' N - 250' E SOUTH

Location _____

Rig up _____

Drilling and Remarks:

D. N. O.

2200

RECORD

Cased _____ in., _____ ft.

Sand _____

Gas _____

Oil _____

Total Depth _____

PRODUCTION

1st 24 hrs. Nat. _____

1st 24 hrs. after shot _____

Gas _____ Cu. Ft.

Dry Hole _____

Abandoned _____


Date

8/21 1918

Pyle

Scout

Map No. K 23 Sec. 9 Twp. 22^S R. 4^E
 Well No. 1 Solfer
Crawford et al Company
 Contractor

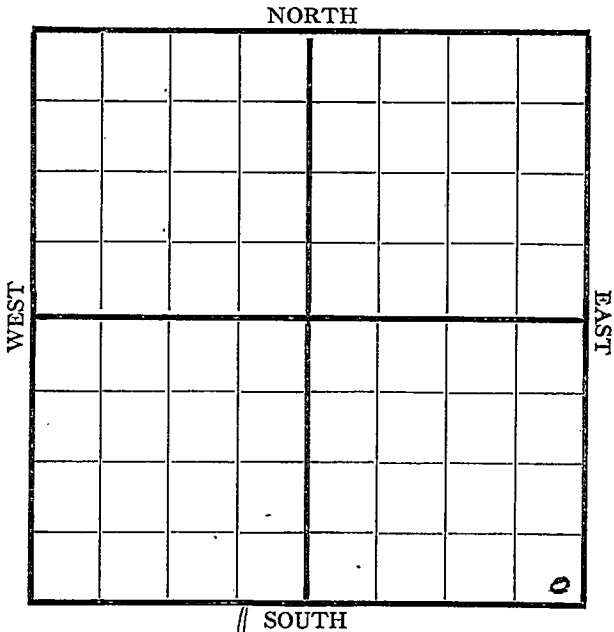

Location 250 N 1 D
250 W 2 E
 Rig up _____
 Drilling and Remarks:

2275'

RECORD

Cased _____ in., _____ ft.
 Sand _____
 Gas _____
 Oil _____
 Total Depth _____

PRODUCTION

1st 24 hrs. Nat. _____
 1st 24 hrs. after shot _____
 Gas _____ Cu. Ft.
 Dry Hole _____
 Abandoned _____

Date

8/29 1918

D. Vile

Scout


Map No. 1523 Sec. 9 Twp. 22 R. 4Well No. 1 GallopCrawford et al Company

Contractor

NORTH

WEST

EAST

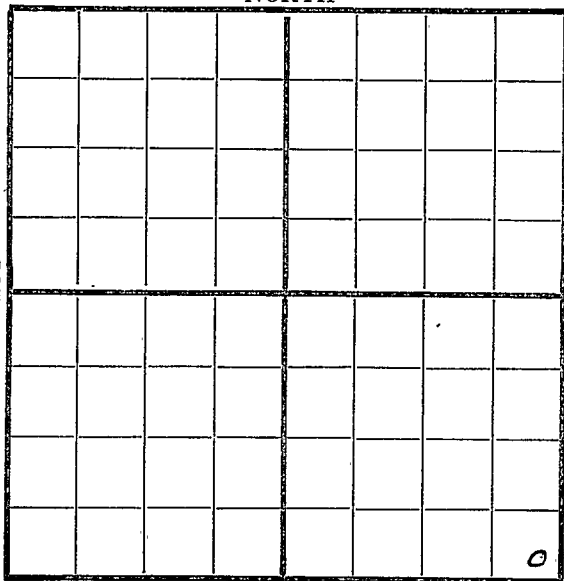

SOUTH

Location _____

Rig up _____

Drilling and Remarks:

250' 54E2430'

RECORD

Cased _____ in., _____ ft.

Sand _____

Gas _____

Oil _____

Total Depth _____

PRODUCTION

1st 24 hrs. Nat. _____

1st 24 hrs. after shot _____

Gas _____ Cu. Ft.

Dry Hole _____

Abandoned _____

Date

9/3

191

8**Pyle**


Scout

Map No. 1523 Sec. 9 Twp. 22 R. 4Well No. 1 101 ft
Crawford et al Company
Contractor

NORTH

WEST

EAST

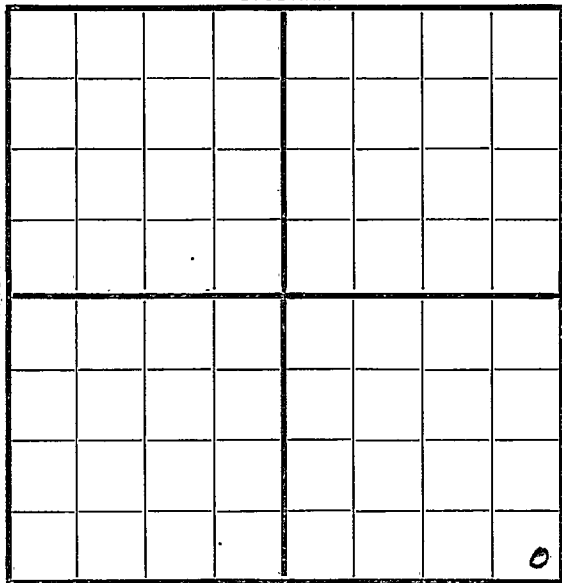

SOUTH

Location 250 } 07E

Rig up _____

Drilling and Remarks:

Top. O. 2505'
1 ft in.
The 2100 ft of oil
proved to be
mostly water

RECORD

Cased _____ in., _____ ft.

Sand _____

Gas _____

Oil _____

Total Depth _____

PRODUCTION

1st 24 hrs. Nat. _____

1st 24 hrs. after shot _____

Gas _____ Cu.

Dry Hole _____

Abandoned _____

Date

9/

1918


13

Pyle

Map No. 1523 Sec. 9 Twp. 22 R. 4Well No. 1 John
Crawford et al Company

Contractor

NORTH

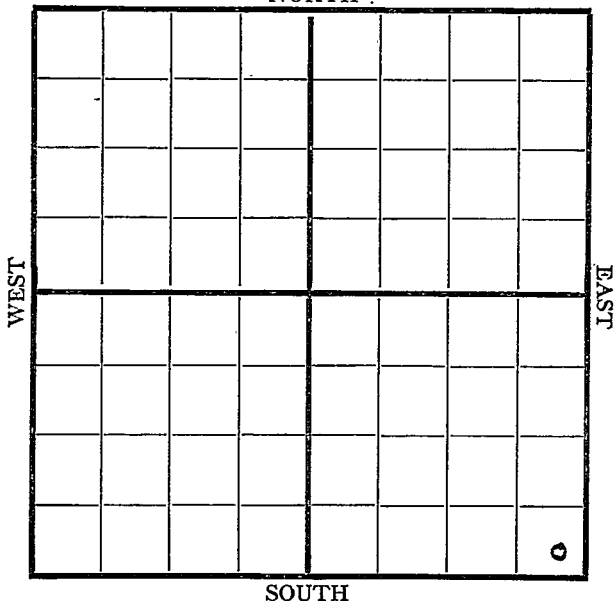

SOUTH

Location 250' S. & E

Rig up _____

Drilling and Remarks:

*fishing for
bailer @
2505'*

RECORD

Cased _____ in., _____ ft.

Sand _____

Gas _____

Oil _____

Total Depth _____

PRODUCTION

1st 24 hrs. Nat. _____

1st 24 hrs. after shot _____

Gas _____ Cu. Ft.

Dry Hole _____


Abandoned _____

Date

9/24 1918

Pyle Scout

Map No. 1523 Sec. 9 Twp. 22 R. 4
 Well No. 1 Salpe
Crawford et al Company
 Contractor

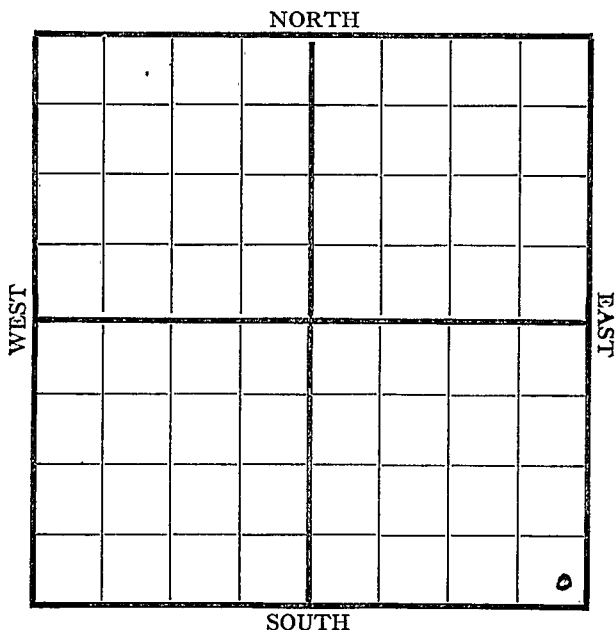

Location 250 S-E

Rig up _____

Drilling and Remarks:

tubing

RECORD

Cased _____ in., _____ ft.
 Sand 2504 - 2506
 Gas _____
 Oil _____
 Total Depth _____

PRODUCTION

1st 24 hrs. Nat. _____
 1st 24 hrs. after shot _____
 Gas _____ Cu. Ft.
 Dry Hole _____
 Abandoned _____

Date

12/3 1918

Pyle

Scout