

Map No.----- Sec. 9 Twp. 22 R. 4

Well No. 2 Isell Farm

Elmhurst Dec Company

NORTH

WEST

EAST

COMPLETION


Map No. K 23 Sec. 9 Twp. 22 R. 4Well No. 2 Pollipe
Elmhurst West Company

Contractor

NORTH

WEST

EAST

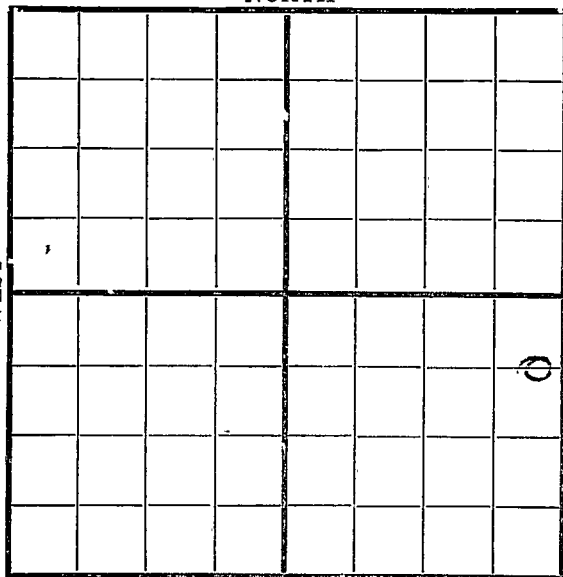

660 N

SOUTH

200 E

Location _____

Rig up ☒

Drilling and Remarks:

RECORD

Cased _____ in., _____ ft.

Sand _____

Gas _____

Oil _____

Total Depth _____

PRODUCTION

1st 24 hrs. Nat. _____

1st 24 hrs. after shot _____

Gas _____ Cu. Ft.

Dry Hole _____

Abandoned _____

Date

3/28

1919

Pyle

Scout


Map No. K 23 Sec. 9 Twp. 22 R. 4Well No. 2 Little
Elmhurst West Company

Contractor

NORTH

WEST

EAST

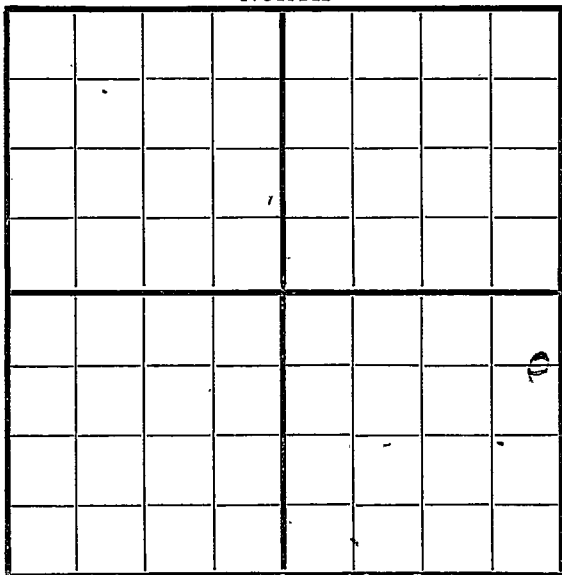

SOUTH

660 N

200 E

Location _____

Rig up _____

Drilling and Remarks:

Rigged up

RECORD

Cased _____ in., _____ ft.

Sand _____

Gas _____

Oil _____

Total Depth _____

PRODUCTION

1st 24 hrs. Nat. _____

1st 24 hrs. after shot _____

Gas _____ Cu. Ft.

Dry Hole _____

Abandoned _____

Date

Pyle

Scout

1919


Map No. K 23 Sec. 9 Twp. 22 R. 4Well No. 2 HalliburtonElmhurst Dev Company

Contractor

NORTH

WEST

EAST

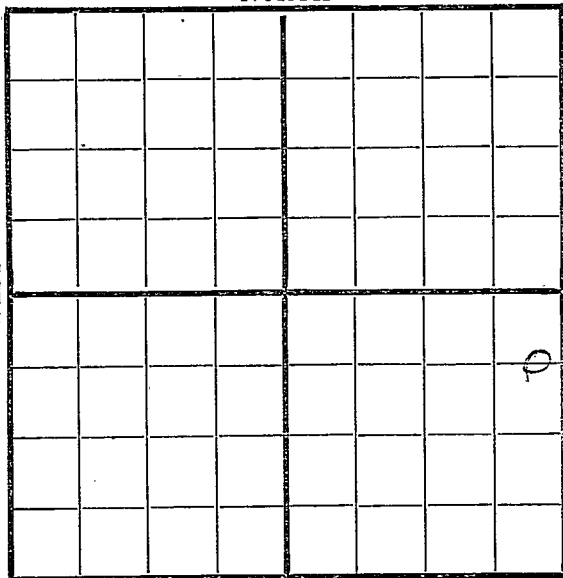

660 N

SOUTH

200 E

Location _____

Rig up _____

Drilling and Remarks:

Spudding

RECORD

Cased _____ in., _____ ft.

Sand _____

Gas _____

Oil _____

Total Depth _____

PRODUCTION

1st 24 hrs. Nat. _____

1st 24 hrs. after shot _____

Gas _____ Cu. Ft.

Dry Hole _____

Abandoned _____

Date

4/17

191

9

C. L. h.


Scout

Map No. K 23 Sec. 9 Twp. 22 R. 4
 Well No. 2 Callie
Elmhurst West Company
 Contractor

NORTH

WEST

EAST

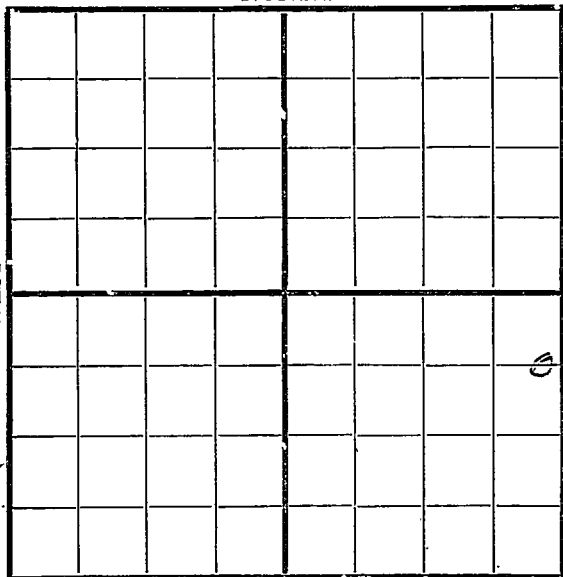

660 N

SOUTH

200 E

Location _____

Rig up _____

Drilling and Remarks:

375'

RECORD

Cased _____ in., _____ ft.

Sand _____

Gas _____

Oil _____

Total Depth _____

PRODUCTION

1st 24 hrs. Nat. _____

1st 24 hrs. after shot _____

Gas _____ Cu. Ft.

Dry Hole _____

Abandoned _____

Date

4/16 1919

Pyle


Scout

Map No. K23 Sec. 9 Twp. 22 R. 4
 Well No. 2 Valley
Chambers & Co Company
 Contractor

NORTH

WEST

EAST

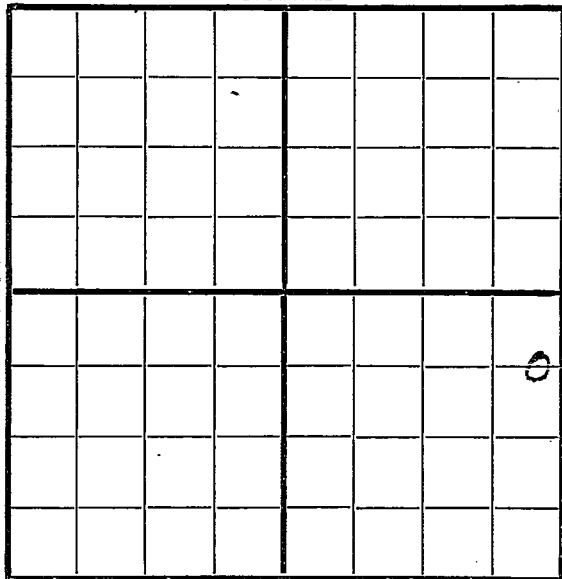

SOUTH

660 N

200 E

Location _____

Rig up _____

Drilling and Remarks:

700'

RECORD

Cased _____ in., _____ ft.

Sand _____

Gas _____

Oil _____

Total Depth _____

PRODUCTION

1st 24 hrs. Nat. _____

1st 24 hrs. after shot _____

Gas _____ Cu. Ft.

Dry Hole _____

Abandoned _____

Date

4/21


1919

Pyle

Scout

Map No. 1523 Sec. 9 Twp. 22 R. 4
 Well No. 2 Jolliffe
Elmhurst Dev. Company
 Contractor

NORTH

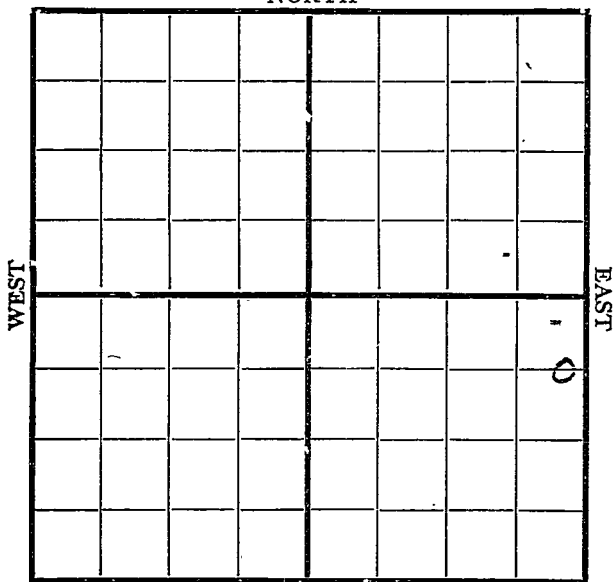

660 N

SOUTH

200 E

Location _____

Rig up _____

Drilling and Remarks:

1100'

12" hole

RECORD

Cased _____ in., _____ ft.

Sand _____

Gas _____

Oil _____

Total Depth _____

PRODUCTION

1st 24 hrs. Nat. _____

1st 24 hrs. after shot _____

Gas _____ Cu. Ft.

Dry Hole _____

Abandoned _____

Date

5/10

1919

Pyle Scout


Map No. K 23 Sec. 9 Twp. 22 R. 4Well No. 2 JalliffeElmhurst Dev Company

Contractor

NORTH

WEST

EAST

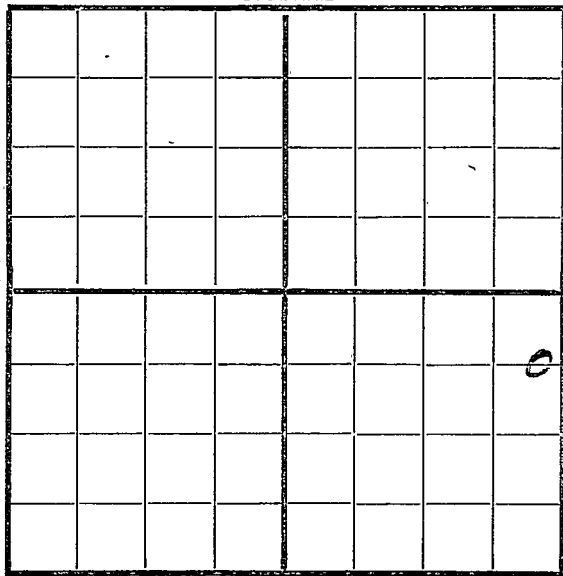

660 N

SOUTH

200 E

Location _____

Rig up _____

Drilling and Remarks:

1100'

12" hole

RECORD

Cased _____ in., _____ ft.

Sand _____

Gas _____

Oil _____

Total Depth _____

PRODUCTION

1st 24 hrs. Nat. _____

1st 24 hrs. after shot _____

Gas _____ Cu. Ft.

Dry Hole _____

Abandoned _____

Date

5/1 1919


Pyle

Scout

Map No. K 23 Sec. 9 Twp. 22 R. 4Well No. 2 JolliffElmhurst West Company

Contractor

NORTH

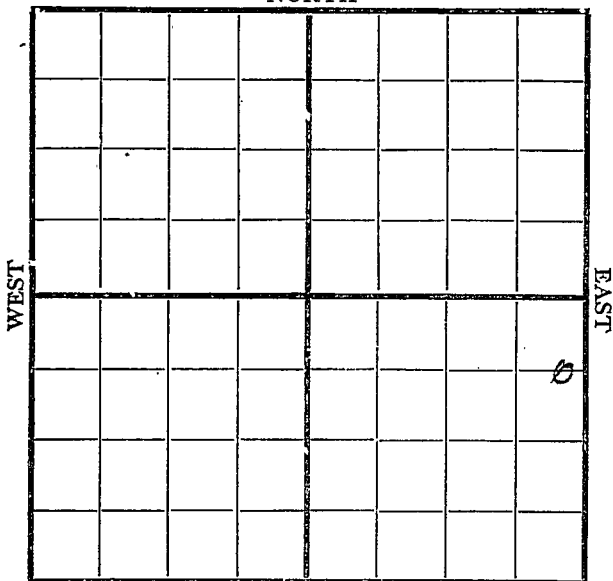

660 N SOUTH

200 E

Location _____

Rig up _____

Drilling and Remarks:

1600'

RECORD

Cased _____ in., _____ ft.

Sand _____

Gas _____

Oil _____

Total Depth _____

PRODUCTION

1st 24 hrs. Nat. _____

1st 24 hrs. after shot _____

Gas _____ Cu. Ft.

Dry Hole _____

Abandoned _____

Date

5/17

1919


O. G. L.

Scout

Map No. 523 Sec. 9 Twp. 22 R. 4Well No. 2 Jaliff
Elmhurst Company

Contractor

NORTH

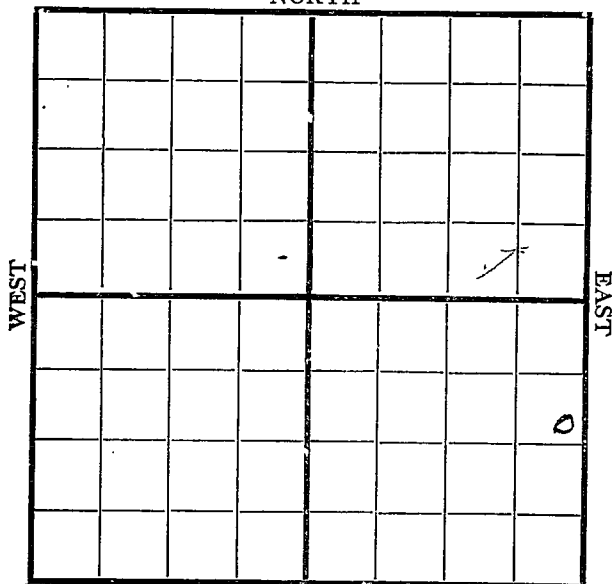

1120 N

SOUTH

200 E

Location _____

Rig up _____

Drilling and Remarks:

Set 10" @
1715'

RECORD

Cased _____ in., _____ ft.

Sand _____

Gas _____

Oil _____

Total Depth _____

PRODUCTION

1st 24 hrs. Nat. _____

1st 24 hrs. after shot _____

Gas _____ Cu. Ft.

Dry Hole _____

Abandoned _____

Date

57
/ 21

191

9

Pyle


Scout

Map No. K 23 Sec. 9 Twp. 22 R. 4Well No. 2 Elmhurst

Company

Contractor

NORTH

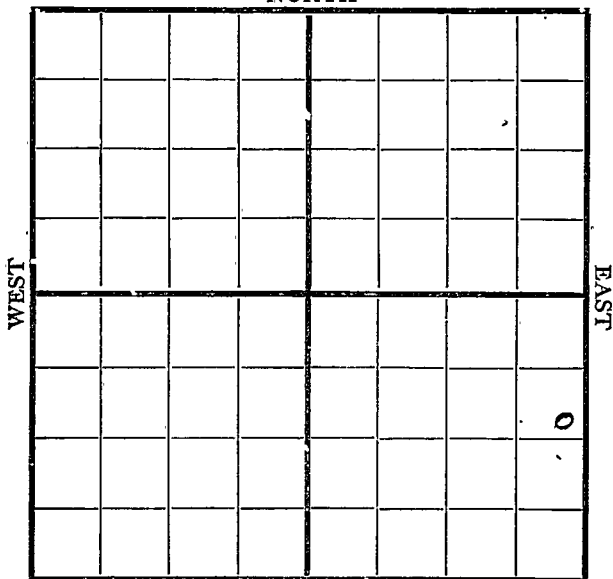

1120 N SOUTH

200 E

Location

Rig up

Drilling and Remarks:

2150'

RECORD

Cased.....in.,ft.

Sand.....

Gas.....

Oil.....

Total Depth.....

PRODUCTION

1st 24 hrs. Nat.

1st 24 hrs. after shot.....

Gas.....Cu. Ft.

Dry Hole.....

Abandoned.....

Date

5/31

1919


Pyle

Scout

Map No. K 23 Sec. 9 Twp. 22 R. 4Well No. 2 CallippeElmhurst Company

Contractor

NORTH

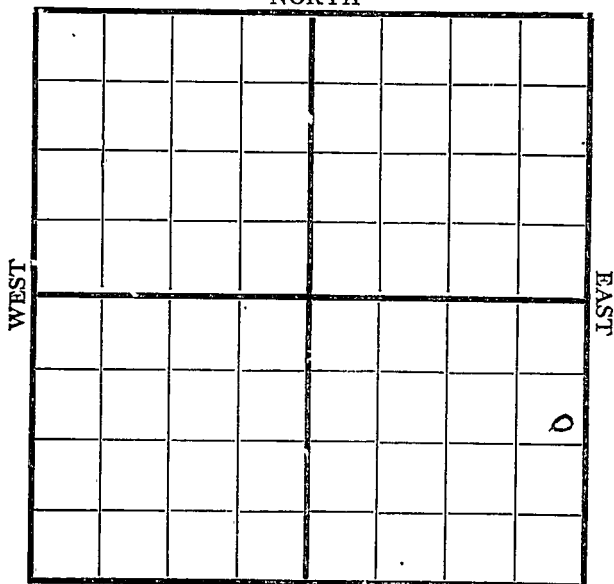

SOUTH

1120 N

200 E

Location _____

Rig up _____

Drilling and Remarks:

RECORD

Cased _____ in., _____ ft.

Sand _____

Gas _____

Oil _____

Total Depth _____

PRODUCTION

1st 24 hrs. Nat. _____

1st 24 hrs. after shot _____

Gas _____ Cu. Ft.

Dry Hole _____

Abandoned _____

Top Sand 2514
 6 ft in
 200 ft oil
 in hole

Date

6/ 1919

PV

Scout

Map No. K 13 Sec. 9 Twp. 22 R. 4

Well No. 2 Hollister

Elmquist Int

Company

Contractor

NORTH

WEST

EAST

SOUTH

1120 ✓

200 E

Location _____

Rig up_____

Drilling and Remarks:

900 ft oil in
hole - D. D.
for orders

RECORD

Cased.....in.,ft.

Sand 2514 - 2520

Gas _____

Oil_____

Total Depth_____

PRODUCTION

1st 24 hrs. Nat.

1st 24 hrs. after shot-----

Gas.....Cu. Ft.

Dry Hole.....

Abandoned _____

Date _____

$$\frac{6}{14}$$

191. 9

Py1-

Scout

Map No. K 23 Sec. 9 Twp. 22 R. 4

Well No. 2 See sketch

Elmhurst

Company

Contractor

NORTH

WEST

EAST

1120 N

SOUTH

2005

Location _____

Rig up_____

Drilling and Remarks:

Running

over

RECORD

Cased-----in., -----ft.

Sand 2514 - 2520

Gas _____

Oil _____

Total Depth_____

PRODUCTION

1st 24 hrs. Nat. -----

1st 24 hrs. after shot-----

Gas.....Cu. Ft.

Dry Hole_____

Abandoned.....

Date _____

6/10 1919

Scout


Map No. K 23 Sec. 9 Twp. 22 R. 4Well No. 2 HalliffElmhurst Company

Contractor

NORTH

WEST

EAST

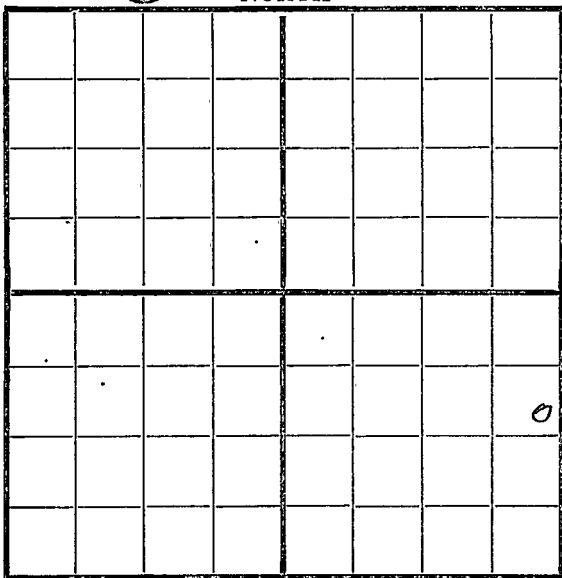

200 E

SOUTH

1120 N

Location _____

Rig up _____

Drilling and Remarks:

Started to
pump & rods
parted also
lost fishing
Tools

RECORD

Cased _____ in., _____ ft.

Sand 2514 - 2520

Gas _____

Oil 900 ft.

Total Depth _____

PRODUCTION

1st 24 hrs. Nat. _____

1st 24 hrs. after shot _____

Gas _____ Cu. Ft.

Dry Hole _____

Abandoned _____

Date

6/18
1919

Pyle

Scout


Map No. *K 23* Sec. *9* Twp. *22* R. *4*Well No. *2 Joliffe*
Elmhurst Company

Contractor

NORTH

WEST

EAST

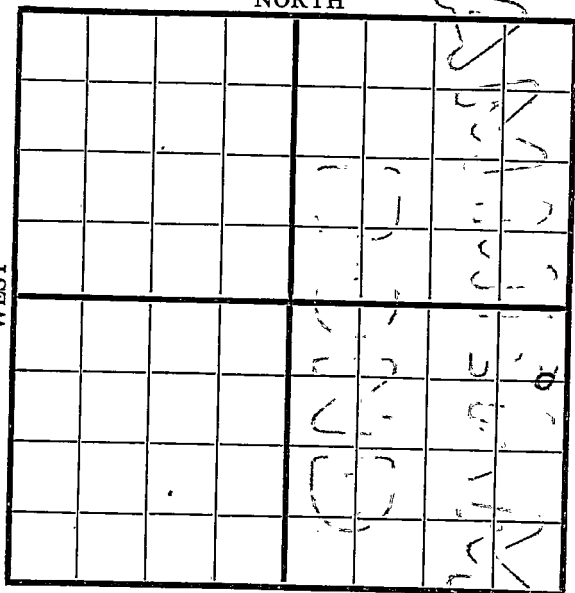

200 E

SOUTH

660 N

Location _____

Rig up _____

Drilling and Remarks:

*1/2 % B. S.**No water**35° gravity*

RECORD

Cased _____ in., _____ ft.

Sand _____

Gas _____

Oil _____

Total Depth _____

PRODUCTION

1st 24 hrs. Nat. _____

1st 24 hrs. after shot _____

Gas _____ Cu. Ft.


Dry Hole _____

Abandoned _____

Date

7/21 191*9**Pyle* Scout

Map No. K 23 Sec. 9 Twp. 22 R. 4
 Well No. 2 Pollock
Elmhurst West. Company _____
 Contractor _____

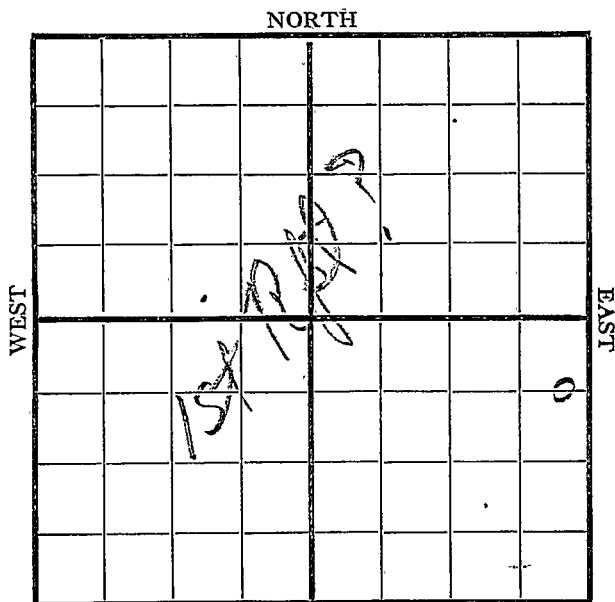

660 N

SOUTH

200 E

Location _____

Rig up ☒ _____

Drilling and Remarks:

RECORD

Cased _____ in., _____ ft.

Sand _____

Gas _____

Oil _____

Total Depth _____

PRODUCTION

1st 24 hrs. Nat. _____

1st 24 hrs. after shot _____

Gas _____ Cu. Ft.

Dry Hole _____

Abandoned _____

Date

3/21


191

9

Pyle

Scout

Map No. K 23 Sec. 9 Twp. 22 R. 4
 Well No. 2 Joliffe
Elmhurst Company
 Contractor

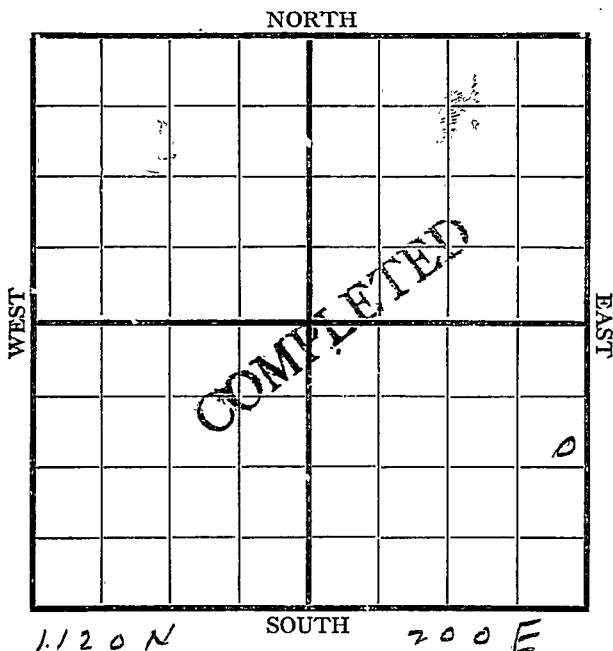

Location _____

Rig up _____

Drilling and Remarks:

RECORD

Cased _____ in., _____ ft.

Sand 2514 - 2520

Gas _____

Oil _____

Total Depth _____

PRODUCTION1st 24 hrs. Nat. 500 bbls

1st 24 hrs. after shot _____

Gas _____ Cu. Ft.

Dry Hole _____

Abandoned _____

Date

6/25 1919 J. L. Scout