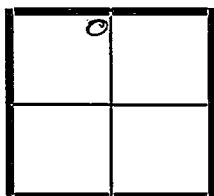


Sec. 9 Twp. 22 Range 4E

#2 Jolliffe

Kansas Geological Society

· Skelly Scout Tickets

Map No. _____ Sec. 9 Twp. 22 R. 4Well No. 2 Jaliffe FarmWatcham et al Company_____
ContractorMU. Quarter200 Ft. from N. Line_____
Ft. from S. Line_____
Ft. from E. Line1170 Ft. from W. LineD 1914

REPORT

9/13	Tools
10/20	Spinning
10/30	Drill 350'
11/3	Drill 850'
12	Drill 1235'
18	Drill 1300'
24	Drill 1500'
12/1	Drill 1600'
12/8	A.D. 1625'
15	Shut down 1625'
22	Shut down 1625'
31	2493'
1/6/20	Band 2495' - 2499'
	Too Blk.

Map No. K 23 S 9 Twp. 22 R. 4Well No. 2
Hatchman et al Company

Contractor

SECTION PLAT

200 Ft. from N. Line

Ft. from S. Line

Ft. from E. Line

1120 Ft. from W. Line

0			

Location

Rig up

Drilling and Remarks:

RECORD

Cased _____ in., _____ ft.

Sand _____

Gas _____

Oil _____

Total Depth _____

PRODUCTION

1st 24 hrs. Nat. _____

1st 24 hrs. after shot _____

Gas _____ Cu. Ft.

Dry Hole _____

Abandoned _____

Date

9/29 1919

Pyle

Scout

Map No. K 22 S 9 Twp 22 R 4Well No. 2 CalliperHatchman et al Company

Contractor

SECTION PLAT

200 Ft. from N. Line

Ft. from S. Line

Ft. from E. Line

1120 Ft. from W. Line

0			

Location

Rig up

Drilling and Remarks:

RECORD

Cased in, ft.

Sand

Gas

Oil

Total Depth

PRODUCTION

1st 24 hrs. Nat.

1st 24 hrs. after shot

Gas Cu. Ft.

Dry Hole

Abandoned

Date

9/19 191 9

Pyle

Scout

Map No. K23 Sec. 9 Twp. 22 R. 4Well No. 2 Holliffe
Hatchorn et al Company

Contractor

SECTION PLAT

200 Ft. from N. Line

Ft. from S. Line

Ft. from E. Line

1120 Ft. from W. Line

0			

Location

Rig up

Drilling and Remarks:

Tools

RECORD

Cased _____ in., _____ ft.

Sand _____

Gas _____

Oil _____

Total Depth _____

PRODUCTION

1st 24 hrs. Nat. _____

1st 24 hrs. after shot _____

Gas _____ Cu. Ft.

Dry Hole _____

Abandoned _____

Date

9/16 1919

Pyle

Scout

Map No. K 23 Sec. 9 Twp. 22 R. 4Well No. 2 JalliffeHatchorn et al Company

Contractor

SECTION PLAT

200 Ft. from N. Line

Ft. from S. Line

Ft. from E. Line

1120 Ft. from W. Line

0			

Location

Rig up ☒

Drilling and Remarks:

RECORD

Cased _____ in., _____ ft.

Sand _____

Gas _____

Oil _____

Total Depth _____

PRODUCTION

1st 24 hrs. Nat. _____

1st 24 hrs. after shot _____

Gas _____ Cu. Ft.

Dry Hole _____

Abandoned _____

Date

9/8 1919

Pyle

Scout

Map No. K 23 Sec. 9 Twp. 22 R. 4Well No. 2 Galliffe
Hatchorn et al Company

Contractor

SECTION PLAT

700 Ft. from N. Line

Ft. from S. Line

Ft. from E. Line

1120 Ft. from W. Line

0			

Location

Rig up ☒

Drilling and Remarks:

RECORD

Cased _____ in., _____ ft.

Sand _____

Gas _____

Oil _____

Total Depth _____

PRODUCTION

1st 24 hrs. Nat. _____

1st 24 hrs. after shot _____

Gas _____ Cu. Ft.

Dry Hole _____

Abandoned _____

Date

9/1 191 1

Pyle


Scout

Map No. K 23 Sec. 9 Twp. 22 R. 14
 Well No. 2 Jallippe
Watchorn et al Company
 Contractor

NORTH

WEST

EAST

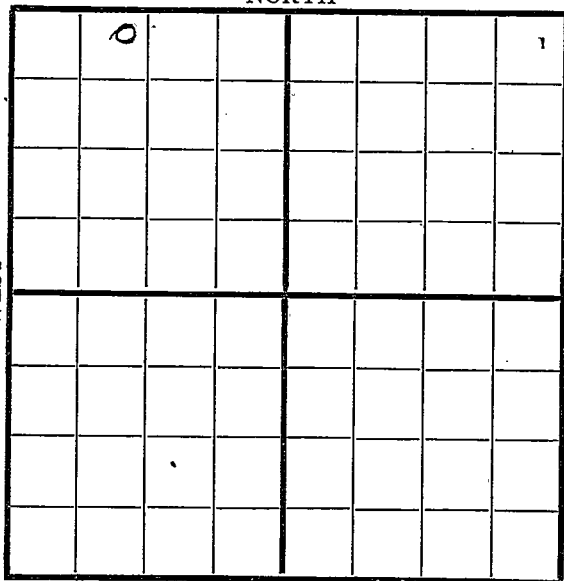

SOUTH

200 N

1120 W

Location

Rig up ☒

Drilling and Remarks:

RECORD

Cased _____ in., _____ ft.

Sand _____

Gas _____

Oil _____

Total Depth _____

PRODUCTION

1st 24 hrs. Nat. _____

1st 24 hrs. after shot _____

Gas _____ Cu. Ft.

Dry Hole _____


Abandoned _____

Date

8/15 1919 9 C. J. C. Scout

Map No. K 23 Sec. 9 Twp. 22 R. 4
 Well No. 2 Gallipoli
Hatchorn et al Company
 Contractor

NORTH

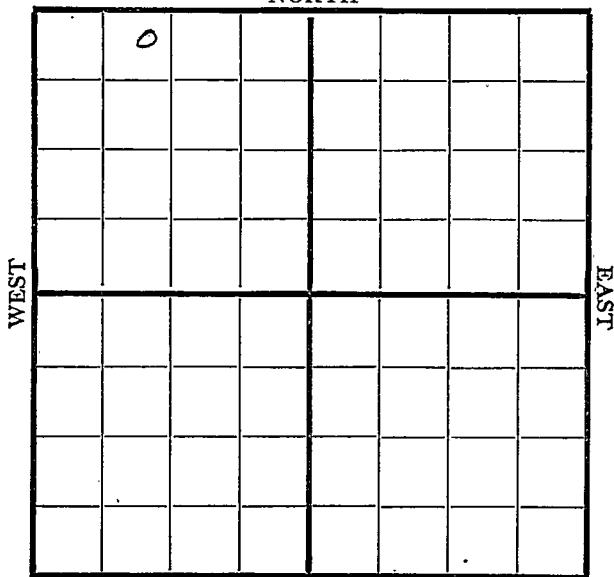

100 N

SOUTH

1120 W

Location _____

Rig up ☒ _____

Drilling and Remarks:

RECORD

Cased _____ in., _____ ft.

Sand _____

Gas _____

Oil _____

Total Depth _____

PRODUCTION

1st 24 hrs. Nat. _____

1st 24 hrs. after shot _____

Gas _____ Cu. Ft.

Dry Hole _____

Abandoned _____

Date

Pyie

191

9


Scout

8/11

Map No. K 23 Sec. 9 Twp. 22 R. 4Well No. 2 Gallie

Contractor

NORTH

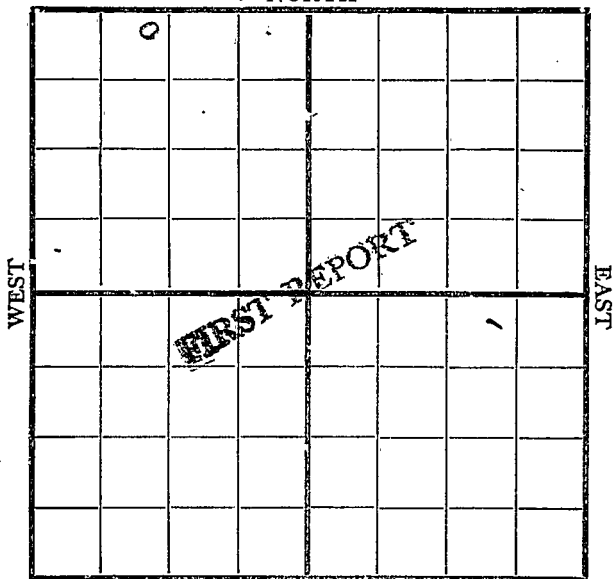

200 N

SOUTH

1120 30'

Location _____

Rig'up _____

Drilling and Remarks:

Timbers

RECORD

Cased _____ in., _____ ft.

Sand _____

Gas _____

Oil _____

Total Depth _____

PRODUCTION

1st 24 hrs. Nat. _____

1st 24 hrs. after shot _____

Gas _____ Cu. Ft.

Dry Hole _____

Abandoned _____

Date

8/14 1919 Pyle Scout

Map No. 1523 Sec. 9 Twp. 22 R. 4
 Well No. 2 Halliff
Hatchorn et al Company
 Contractor

SECTION PLAT

200 Ft. from N. Line
 _____ Ft. from S. Line
 _____ Ft. from E. Line
1120 Ft. from W. Line

0			

Location _____
 Rig up _____
 Drilling and Remarks:

RECORD

Cased _____ in., _____ ft.
 Sand _____
 Gas _____
 Oil _____
 Total Depth _____

PRODUCTION

1st 24 hrs. Nat. _____
 1st 24 hrs. after shot _____
 Gas _____ Cu. Ft.
 Dry Hole _____
 Abandoned _____

Date

10/6 1919 Pyle Scout

Map No. 1523 Sec. 9 Twp. 22 R. 4Well No. 2 FalliffHatchom et al Company

Contractor

SECTION PLAT

200 Ft. from N. Line

_____ Ft. from S. Line

_____ Ft. from E. Line

1120 Ft. from W. Line

0			

Location _____

Rig up _____

Drilling and Remarks:

Spud

RECORD

Cased _____ in., _____ ft.

Sand _____

Gas _____

Oil _____

Total Depth _____

PRODUCTION

1st 24 hrs. Nat. _____

1st 24 hrs. after shot _____

Gas _____ Cu. Ft.

Dry Hole _____

Abandoned _____

Date

10/20 1919

Pyle

Scout

Map No. K 23 Sec. 9 Twp. 22 R. 4Well No. 2 JalliffeHatchorn et al Company

Contractor

SECTION PLAT

200 Ft. from N. Line

Ft. from S. Line

Ft. from E. Line

1120 Ft. from W. Line

0			

Location

Rig up

Drilling and Remarks:

Isols

RECORD

Cased _____ in., _____ ft.

Sand _____

Gas _____

Oil _____

Total Depth _____

PRODUCTION

1st 24 hrs. Nat. _____

1st 24 hrs. after shot _____

Gas _____ Cu. Ft.

Dry Hole _____

Abandoned _____

Date

10/131919Pyle

Scout

Map No. K 23 Sec. 9 Twp. 22 R. 4Well No. 2 JalliffeWatchorn et al Company


Contractor

SECTION PLAT

200 Ft. from N. Line

Ft. from S. Line

Ft. from E. Line

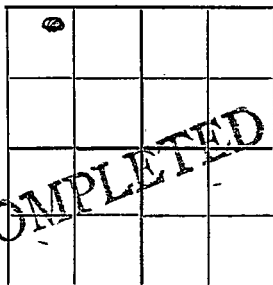1120 Ft. from W. Line

Location

Rig up

Drilling and Remarks:

RECORD

Cased _____ in. _____ ft.

Sand 2495-2499

Gas _____

Oil _____

Total Depth _____

PRODUCTION

1st 24 hrs. Nat. 700 bbls

1st 24 hrs. after shot _____

Gas _____ Cu. Ft.

Dry Hole _____

Abandoned _____

Date

Pyle

1/6 191 9

Scov