


Map No. _____ Sec. 9 Twp. 22 R. 4Well No. 3 Jalliffe Farm _____Watshorn et al Company _____

N

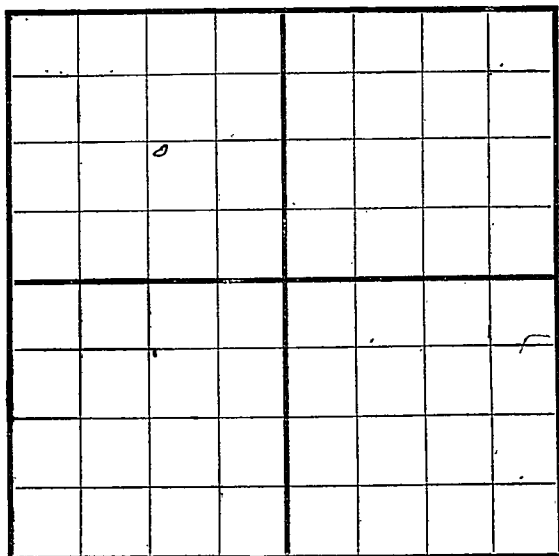

COMPT ENT

Location _____

Drilling Remarks:

Rig Up _____

Drilling Remarks:

RECORD

Cased _____ in. _____ ft.

Sand _____

Gas _____

Oil _____

Total Depth _____

PRODUCTION

1st 24 hrs. Nat. _____

1st 24 hrs. after shot _____

Gas _____ cu. ft.

Dry Hole _____


Abandoned _____

Map No. _____ Sec. 9 Twp. 22 R. 4Well No. 3 Jaliffe FarmWatcham et al Company

Contractor _____

NW Quarter~~705~~ Ft. from N. Lice1120 Ft. from S. Line~~940~~ Ft. from E. Line

_____ Ft. from W. Line

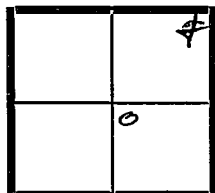

Date	REPORT
10/1/3	Timbers
10/20	Timbers on Ground
10-30	J.O. G.
11/3	Timbers
12	Timbers
18	Timbers
24	Rig
12/1	Rig
17/8	Rig up.
15	Rig up.
22	Rig up.
1	Tools
11/6/20	spud
15	Dbl 300'
19	1 1/2" - 1152'
26	fish log 1200'
42	Skid rig
9	Dreg. 400'
16	Dreg. 800'
21	1 1/2" - 1010' - Dreg 1085'
3/1	Dreg. 1450'
8	1870 (over)

COMPLETED

3/15/20 > Aug 2110
22 ✓ 2265'
29 Loh 2505-14FOil
4/12 Sand 2505-23- Tubing
Hole full oil
22 2505-23- 600 FWS.

COMPLETE

Map No. K 25 Sec. 9 Twp. 22 R. 4
Well No. 3 Ballinger
Hatchman et al Company
Contractor

SECTION PLAT

200 Ft. from N. Line
_____ Ft. from S. Line
200 Ft. from E. Line
_____ Ft. from W. Line

	2		

Location _____
Rig up _____
Drilling and Remarks:

J. O. H

RECORD

Cased _____ in., _____ ft.
Sand _____
Gas _____
Oil _____
Total Depth _____

PRODUCTION

1st 24 hrs. Nat. _____
1st 24 hrs. after shot _____
Gas _____ Cu. Ft.
Dry Hole _____
Abandoned _____

Date 9/1 1919 Pyle Scout
1/29

Map No. K23 Set. 9 Twp. 22 R. 4Well No. 3 For CliffsHatchorn et al Company

Contractor

SECTION PLAT

200 Ft. from N. Line

_____ Ft. from S. Line

200 Ft. from E. Line

_____ Ft. from W. Line

	<u>0</u>		

Location _____

Rig up _____

Drilling and Remarks:

L.O. 1/2

RECORD

Cased _____ in., _____ ft.

Sand _____

Gas _____

Oil _____

Total Depth _____

PRODUCTION

1st 24 hrs. Nat. _____

1st 24 hrs. after shot _____

Gas _____ Cu. Ft.

Dry Hole _____

Abandoned _____

Date

Pyle

9/22 1919

Scout

Map No. K 23 Sec. 9 Twp. 22 R. 4Well No. 3 Jalliffe
Hatchow et al Company

Contractor

SECTION PLAT

200 Ft. from N. Line

_____ Ft. from S. Line

200 Ft. from E. Line

_____ Ft. from W. Line

	6		

Location _____

Rig up _____

Drilling and Remarks:

J. O. D.

RECORD

Cased _____ in., _____ ft.

Sand _____

Gas _____

Oil _____

Total Depth _____

PRODUCTION

1st 24 hrs. Nat. _____

1st 24 hrs. after shot _____

Gas _____ Cu. Ft.

Dry Hole _____

Abandoned _____

Date

9/16 1919Pyle

Scout

Map No. K 23 Sec. 9 Twp. 22 R. 4Well No. 3 Jalliffe
Hatchorn et al Company

Contractor

SECTION PLAT

200 Ft. from N. Line

Ft. from S. Line

200 Ft. from E. Line

Ft. from W. Line

Location

Rig up

Drilling and Remarks:

I. O. G.

RECORD

Cased _____ in., _____ ft.

Sand _____

Gas _____

Oil _____

Total Depth _____

PRODUCTION

1st 24 hrs. Nat. _____

1st 24 hrs. after shot _____

Gas _____ Cu. Ft.

Dry Hole _____

Abandoned _____

Date

9/8 1919 16 Scout

Map No. K 23 Sec. 9 Twp. 22 R. 4Well No. 3 BallvilleHatcherson Leif Company

Contractor

SECTION PLAT

200 Ft. from N. Line

Ft. from S. Line

200 Ft. from E. Line

Ft. from W. Line

	2		

Location

Rig up

Drilling and Remarks:

J. O. H.

RECORD

Cased _____ in., _____ ft.

Sand _____

Gas _____

Oil _____

Total Depth _____

PRODUCTION

1st 24 hrs. Nat. _____

1st 24 hrs. after shot _____

Gas _____ Cu. Ft.

Dry Hole _____

Abandoned _____

Date

Pyle

10/6 1919

Scout

Map No. K 23 Sec. 9 Twp. 22 R. 4Well No. 3 GalliffeHatchorn et al Company

Contractor

SECTION PLAT

200 Ft. from N. Line

Ft. from S. Line

200 Ft. from E. Line

Ft. from W. Line

	0		

Location

Rig up

Drilling and Remarks:

I. O. G.

RECORD

Cased _____ in., _____ ft.

Sand _____

Gas _____

Oil _____

Total Depth _____

PRODUCTION

1st 24 hrs. Nat. _____

1st 24 hrs. after shot _____

Gas _____ Cu. Ft.

Dry Hole _____

Abandoned _____

Date

10/20 191 9Pyle

Scout

Map No. K 23 Sec. 9 Twp. 22 R. 4Well No. 3 Jalliffe
Hatchorn et al Company

Contractor

SECTION PLAT

200 Ft. from N. Line

Ft. from S. Line

200 Ft. from E. Line

Ft. from W. Line

	<u>2</u>		

Location

Rig up

Drilling and Remarks:

Timbers

RECORD

Cased _____ in., _____ ft.

Sand _____

Gas _____

Oil _____

Total Depth _____

PRODUCTION

1st 24 hrs. Nat. _____

1st 24 hrs. after shot _____

Gas _____ Cu. Ft.

Dry Hole _____

Abandoned _____

Date

10/13 1919 Pyle Scout

Map No. K23, Sec. 9, Twp. 22 R. 4Well No. 3 JeffHatchman et al Company

Contractor

SECTION PLAT

Ft. from N. Line

1120 Ft. from S. Line1120 Ft. from E. Line

Ft. from W. Line

	o		

FIRST REPORT

Location

Rig up 1

Drilling and Remarks:

*Change Loc
from previous
reports*

RECORD

Cased _____ in., _____ ft.

Sand _____

Gas _____

Oil _____

Total Depth _____

PRODUCTION

1st 24 hrs. Nat. _____

1st 24 hrs. after shot _____

Gas _____ Cu. Ft.

Dry Hole _____

Abandoned _____

Date

Pyle

11/24 1919

S

Map No. K 23 Sec. 9 Twp. 22 R. 4Well No. 3 Jolliffe
Hatchum et al Company

Contractor

SECTION PLAT

Ft. from N. Line

1120 Ft. from S. Line1120 Ft. from E. Line

Ft. from W. Line

	0		

COMPLETED

Location

Rig up

Drilling and Remarks:

RECORD

Cased _____ in., _____ ft.

Sand 2505-23

Gas _____

Oil _____

Total Depth _____

PRODUCTION

1st 24 hrs. Nat. 600 bbls

1st 24 hrs. after shot _____

Gas _____ Cu. Ft.

Dry Hole _____

Abandoned _____

Date

4/22 1920

Pyle

Scout