

Kansas

Map No. _____ Sec. 9 Twp. 22 R. 10


Well No. 1-Pixley Farm _____
Theta Oil Co Company

~~1100~~ Ft. from N. Line

990 Ft. from S. Line

_____ Ft. from E. Line

330 Ft. from W. Line

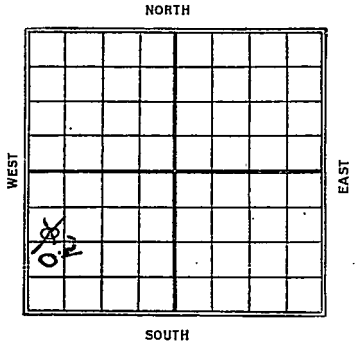

1927

Date

REPORT

3/1	Spudding
3/9	Drly 600
3/16	" 1350
3/24	" 1500
3/30	" 2200
4/7	top sand 2260 - 2301 T.D. P.B. to 2296 - will shoot
4/13	shot 15 gals / 100 bbls I.D. 2301'

to Knwood

21 KANSAS
 Map No. _____ Sec. *9* Twp. *22* R. *10*

Well No. *1*
Dixons

Thetys oil Co Company

Contractor

FIRST REPORTS

SECTION PLAT

1100 Ft. from N. Line

_____ Ft. from S. Line

_____ Ft. from E. Line

330 Ft. from W. Line

<i>0</i>			

Location _____

Rig up _____

Drilling and Remarks:

Spud

RECORD

Cased _____ in., _____ ft.

Sand _____

Gas _____

Oil _____

Total Depth _____

PRODUCTION

1st 24 hrs. Nat. _____

1st 24 hrs. after shot. _____

Gas _____ Cu. Ft.

Dry Hole _____

Abandoned _____

Date

MAR 2 1927

192

CHAS. L. SHERWOOD

Scout

Sherwood

Map No. 21 KANSAS Sec. 9 Twp. 22 R. 10

Well No. 1 *Dixley*
Theto Oil Co Company

Contractor

COMPLETED

SECTION PLAT

1100 Ft. from N. Line
Ft. from S. Line
Ft. from E. Line
200 Ft. from W. Line

0			

Location

Rig up

Drilling and Remarks:

P.B. to 2296

15/100 Bls

RECORD

Cased 2 1/2 in., ft.
Sand 2260-2301
Gas
Oil
Total Depth 2301

PRODUCTION

1st 24 hrs. Nat. _____
1st 24 hrs. after shot _____
Gas _____ Cu. Ft.
Dry Hole _____
Abandoned _____

Date

APR. 13 1917

CHAS. L. SHERWOOD

Scout