


Map No. KANSAS Sec. 9 Twp. 22 R. 10^E

Well No. 2 - Pixley Farm

Peta Oil Company

NORTH

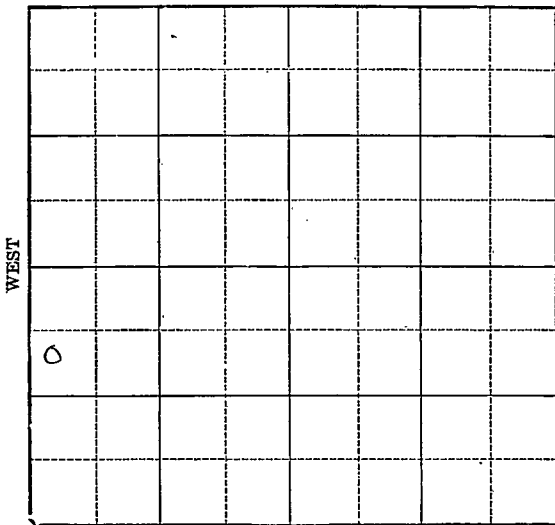

Location _____

Drilling Remarks _____

Rig Up _____

Drilling Remarks _____

RECORD

Cased _____ in. _____ ft.

Sand _____

Gas _____

Oil _____

Total Depth _____

PRODUCTION

1st 24 hrs. Nat. _____

1st 24 hrs. after shot _____

Gas _____ cu. ft. _____

Dry Hole _____

Abandoned _____

Greenwood

Map No. **KANSAS** Sec. 9 Twp. 22 R. 10^E


Well No. 2- Pinsky Farm
Theta Oil Co Company

830 Ft. from N. Line

_____ Ft. from S. Line

_____ Ft. from E. Line

150 Ft. from W. Line
1930

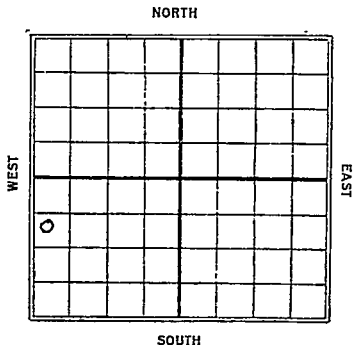

Date

REPORT

5/14

Drill 1400'

5/21

" 1800'

5/28

Land 2317-29

TD. 2329

shot 40 qt

*35 bbl oil
 Sump.*

Greenwood

Map No. 21 **KANSAS** Sec. 9 Twp. 22 R. 10 ^E

Well No. 2 *Pixley*

Theta Oil Co Company

Contractor

FIRST REPORTS

SECTION PLAT

830 Ft. from N. Line

_____ Ft. from S. Line

_____ Ft. from E. Line

150 Ft. from W. Line

Location _____

Rig up _____

Drilling and Remarks:

Log 1400'

RECORD

Cased _____ in., _____ ft.

Sand _____

Gas _____

Oil _____

Total Depth _____

PRODUCTION

1st 24 hrs. Nat. _____

1st 24 hrs. after shot _____

Gas _____ Cu. Ft.

Dry Hole _____

Abandoned _____

Date

MAY 1 4 1930

CHAS. L. SHERWOOD

19

Scout

Greenwood

21

Map No. **KANSAS**

Sec. 9

Twp. 22

R. 10

Well No. 2

Pirley

Theta Oil Co

Company

Contractor

COMPLETE

SECTION PLAT

830 Ft. from N. Line

_____ Ft. from S. Line

_____ Ft. from E. Line

150 Ft. from W. Line

o			

Location _____

Rig up _____

Drilling and Remarks:

40/35 Bls.

RECORD

Cased _____ in., _____ ft.

Sand 2317-2329

Gas _____

Oil _____

Total Depth 2329

PRODUCTION

1st 24 hrs. Nat. _____

1st 24 hrs. after shot _____

Gas _____ Cu. Ft.

Dry Hole _____

Abandoned _____

Date

MAY 28 1930

CHAS. L. SHERWOOD