


Greenwood

KANSAS

SECTION 9 TOWNSHIP 22S RANGE 11E

WELL NO. #W-7 Harris

COMPANY Sunray Mid-Continent Oil Co.

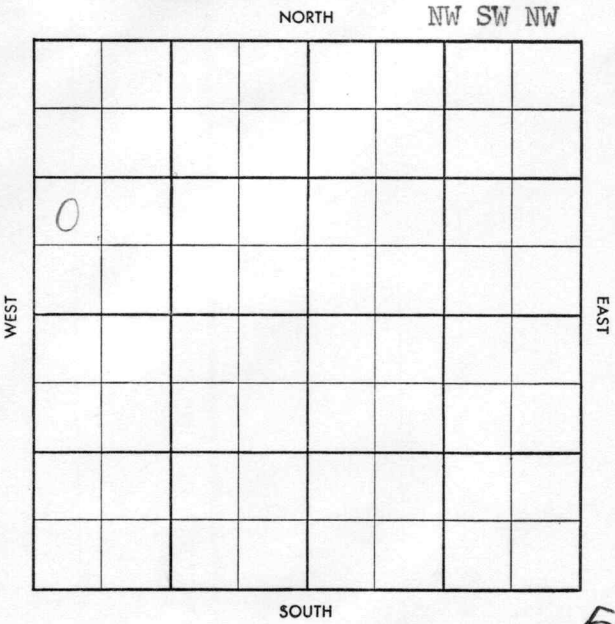

5



