


Section 9 Township 22 Range 11E

Well No. #1 Mignot

Company Inland Oil

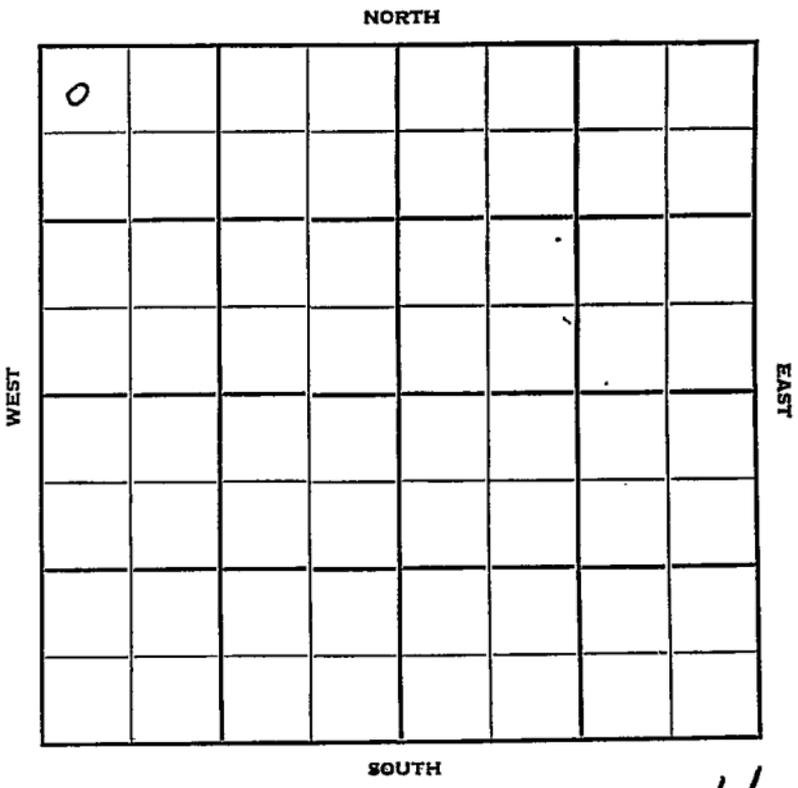

Sec. 9 Twp. 22 R. 11E ✓

Well No. #1 Mignot Farm

Inland Oil Company

Wildcat Contractor


330' Ft. from N. Line

Ft. from S. Line

Ft. from E. Line

480' Ft. from W. Line

NW NW NW

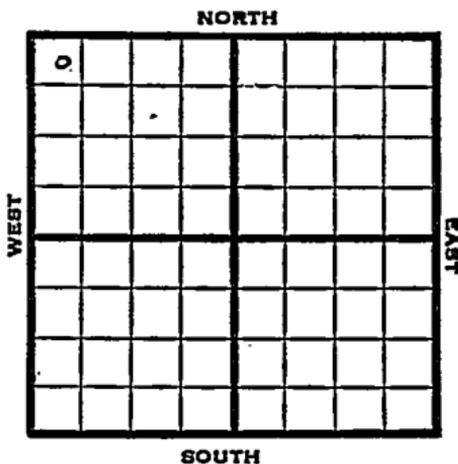

1951

Elev. - REPORT

4/11

Location

5/16

Spud 4-20-51
 Oil W 11 TD 1974
 8" @ 70
 Bart 1909-15
 5" @ 1909
 Sand 1952
 40 qt/1950-61 20 qt/ S/1½bo
 4 bwph TD 1974 wtr
 SP 1966 Comp. 5 bopd

COMPLETED

County **Greenwood** State **Kansas**

Sec. **9** (Blk. Twp.) **22** (Sur. Rge.) **11E** Map No.

Operator **Inland Oil**

Well No. **1** Farm **Mignot**

Elev. Location **NW NW NW**

0					

330 Ft. From **N** Line **NW**

480 Ft. From **W** Line **Quarter**

Ist. Report **APR 11 1951**

Completion

Remarks

Spudding Date

Drlg. Data **Wildcat**

Location

J. E. TYRA

County Greenwood State KansasSec. 9 (Blk.) 22 (Sur.) 11E Map No.Operator Inland OilWell No. 1 Farm MignotElev. Location NW NW NW

0					

330 Ft. From N Line NW480 Ft. From W Line Quarter

1st. Report

Completion MAY 16 1951Remarks WildcatSpudding Date 4-20-51Drlg. Data Oil well TD 19748" @ 70 Bart. 1909-15 5" @ 1909Sand 1952 40 qt/ 1950-61 20 qt/S/ 1½ bo 4 bwph TD 1974 waterSP 1966 Comp. 5 bopd

J. E. TYRA