

Greenwood **KANSAS**

SECTION 9 TOWNSHIP 22 RANGE 11 E

WELL NO. #2 Mignot

COMPANY H. L. Ellis et al

NORTH

	0						

WEST

EAST

SOUTH

4

Greenwood

KANSAS

SEC.	TWP.	R.
9	22	11E

WELL NO.

#2 Mignot

FARM

COMPANY

H.L. Ellis etal

CONTRACTOR

Geneva

Madison


Ft. from N. Line

Ft. from S. Line

Ft. from E. Line

Ft. from W. Line

SE NW NW

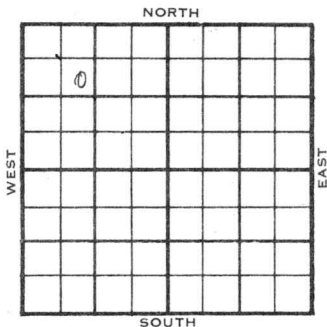

1956	ELEVATION	REPORT
------	-----------	--------

1-25

Comm. 1-22-56

8" @ 101

Drlg. 650

TOPS	DEPTH	LOG	DATUM	Loc. in Sec. _____
Anh.				SE NW NW
TP.				
H.				
Tr.				
Dg.				
Bl.				
L.				
K.C.				Geol. _____
B.K.C.				
Ce.				Contr. _____
C.				Geneva
M.				
M.				Pool _____
K.				
Mz.				Madison
Mq.				
V.				
S.				
S.				
A				
R.				
PE.				
G.				
TD.				

0

JAN 25 1950

FIRST REPORT

Date Comm. 1-22-56
8" @ 101 d rlg. 650

A hand-drawn diagram on lined paper. A line segment starts from the top left and extends towards the center, ending at a point labeled 'S'. From point 'S', a vertical line segment extends downwards. To the right of this vertical segment, there are two small circles, one above the other. The entire diagram is drawn in pencil.

FORM 513 REV. SUNRAY

County Greenwood Sec. 9 Twp. 22 Rge. 11E
 Company H. L. Ellis et al.
 Farm Name Mignot No. 2

	TOPS	DEPTH	LOG	DATUM	Loc in Sec.
Ann.					SE NW NW
TP.					
H.	<u>Barri</u>	<u>1290</u>			
Tf.					
Dg.					
Bl.					
L.					Geol.
K.C.					
ARC.					Cont.
Ce.					<u>Geneva</u>
C.					
M.					Pool
M.					
K.					<u>Madison</u>
Mr.					
Mo.					
V.					
S.					
S.					
A.					
R.					
Pe.					
B.					
W.		<u>1298</u>			

COMPLETE

Date Comm. 1-22-56 FEB 22 1956
 8W @ 101 drlg. 650 FEB 1 1956 4 1/2 1892
 FEB 6 '56 ✓ FEB 15 '56 ✓ FEB 22 '56 ✓ 1923
 TO FO 500' oil 16 hrs. 1700
 POP P. 30 3400 + 50 3400