


Map No. KANSAS Sec. 2 Twp. 23 R. 12
 Well No. 1-Schwab Farm
Transcontinental Company

NORTH

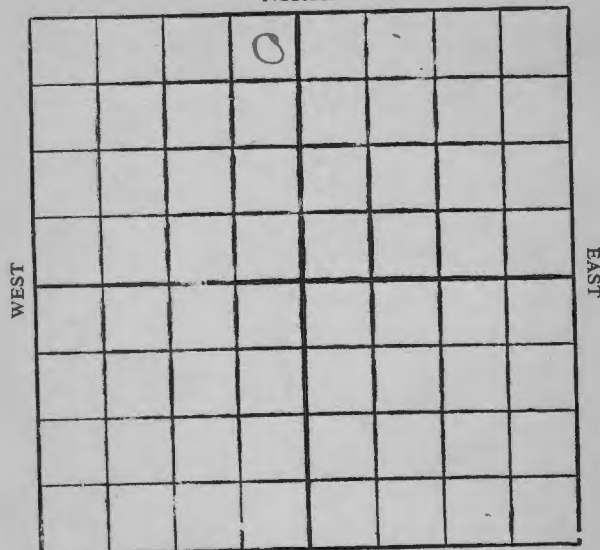

SOUTH

Location
 Drilling Remarks

Rig Up.....
 Drilling Remarks

RECORD

Cased in. ft.
 Sand
 Gas
 Oil
 Total Depth.....

PRODUCTION

1st 24 hrs. Nat.....
 1st 24 hrs. after shot.....
 Gas..... cu. ft.
 Dry Hole.....
 Abandoned.....

Map No. KANSAS Sec. 2 Twp. 23 R. 12
 Well No. 1-Schwab Farm
Transcontinental Company


NORTH

330 Ft. from N. Line

..... Ft. from S. Line

330 Ft. from E. Line

..... Ft. from W. Line

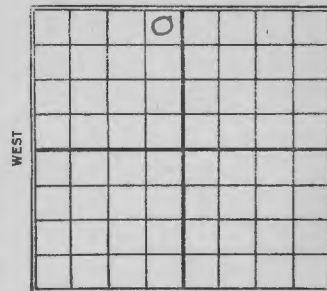

SOUTH

1928

Date

REPORT

2/9 Location
 2/16
 2/23 Rig
 3/1
 3/8 Drlg 550
 3/16 " 1000
 3/22 " 1695
 3/29 First break in line 1725.
 hole full water - Shut down
 4/5
 4/12 1725-1745 - H.F.W.
 L + G. 1745'

1st 24 hrs. Nat.
1st 24 hrs. after shot
Gas cu. ft.
Dry Hole
Abandoned

16 KANSAS Sec. 2 Twp. 23 R. 12
 Map No. 1 Schwab
 Well No. 1 Schwab

Transcontinental Oil Company

Contractor

COMPLETED

SECTION PLAT

330 Ft. from N. Line

Ft. from S. Line

330 Ft. from E. Line

Ft. from W. Line

ABANDONED

Location

Rig up

Drilling and Remarks:

RECORD

Cased in. 1775-1745
 Sand 1775-1745
 Gas
 Oil
 Total Depth 1745

PRODUCTION

1st 24 hrs. Nat.
 1st 24 hrs. after shot
 Gas Cu. Ft.
 Dry Hole
 Abandoned

Date

APR 12 1928

CHAS. L. SHERWOOD Scout

16 KANSAS Sec. 2 Twp. 23 R. 12
 Map No. 1 Schwab

Well No. 1 Schwab
 Transcontinental Oil Co. Company

Contractor

FIRST REPORTS

330 Ft. from N. Line

Ft. from S. Line

330 Ft. from E. Line

Ft. from W. Line

SECTION PLAT

Location

Rig up

Drilling and Remarks:

RECORD

Cased in. ft.
 Sand
 Gas
 Oil
 Total Depth

PRODUCTION

1st 24 hrs. Nat.
 1st 24 hrs. after shot
 Gas Cu. Ft.
 Dry Hole
 Abandoned

Date

FEB 9 1928

CHAS. L. SHERWOOD

Scout