


Map No. Kansas Sec. 22 Twp. 23 R. 12

Well No. 1 well Farm Mc Ginnis & Parish Company

NORTH

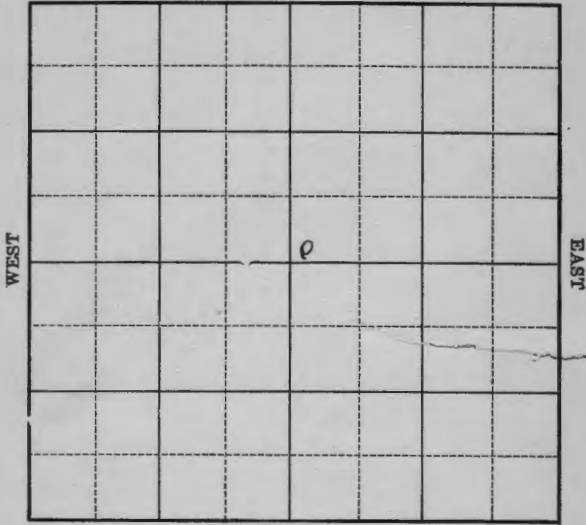

SOUTH

Location \_\_\_\_\_

Drilling Remarks \_\_\_\_\_

Rig Up \_\_\_\_\_

Drilling Remarks \_\_\_\_\_

RECORD

Cased \_\_\_\_\_ in. \_\_\_\_\_ ft.  
 Sand \_\_\_\_\_  
 Gas \_\_\_\_\_  
 Oil \_\_\_\_\_  
 Total Depth \_\_\_\_\_

PRODUCTION


1st 24 hrs. Nat. \_\_\_\_\_  
 1st 24 hrs. after shot \_\_\_\_\_  
 Gas \_\_\_\_\_ cu. ft.  
 Dry Hole \_\_\_\_\_  
 Abandoned \_\_\_\_\_

Map No. Kansas Sec. 22 Twp. 23 R. 12

Well No. 1 well Farm Shenwood Co  
Mc Ginnis & Parish Company

NORTH

\_\_\_\_\_ Ft. from N. Line  
250 Ft. from S. Line  
 \_\_\_\_\_ Ft. from E. Line  
250 Ft. from W. Line

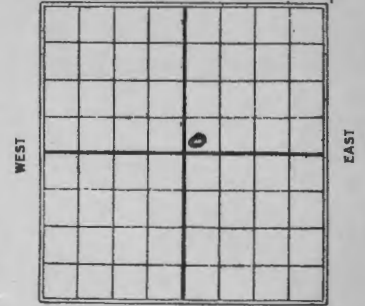

SOUTH

Date 1925 REPORT

9/3 Spudded & S.O.

9/11 \_\_\_\_\_

9/16 \_\_\_\_\_

9/24 \_\_\_\_\_

10/1 \_\_\_\_\_

10/8 \_\_\_\_\_

10/16 1000 @ 800

10/22 ✓ 930

10/29 ✓ 1250'

11/6 S.O. 1250'

11/13 \_\_\_\_\_

11/19 \_\_\_\_\_

11/27 \_\_\_\_\_

12/3 \_\_\_\_\_

12/10 \_\_\_\_\_

12/17 \_\_\_\_\_

12/23 \_\_\_\_\_

12/31 \_\_\_\_\_

1926

1/8 \_\_\_\_\_

1/14 \_\_\_\_\_

1/20 \_\_\_\_\_

1/27 - same

2/4 - \_\_\_\_\_

2/10 - \_\_\_\_\_

2/17 Alg 1640

2/24 Top Lime 1798' Alg 1823'

3/5 - \_\_\_\_\_

3/11 - Abandoned 1835

Greenwood Co

Map No. 16 KANSAS Sec. 22 Twp. 23 R. 12

Well No. 1 holl  
McKinnis & Parrish Company

Contractor

FIRST REPORTS

SECTION PLAT

		o	

Ft. from N. Line  
250  
Ft. from S. Line  
Ft. from E. Line  
250  
Ft. from W. Line

Location -----

Rig up -----

Drilling and Remarks:

Spudded & S/o

RECORD

Cased \_\_\_\_\_ in., \_\_\_\_\_ ft.  
Sand \_\_\_\_\_  
Gas \_\_\_\_\_  
Oil \_\_\_\_\_  
Total Depth \_\_\_\_\_

PRODUCTION

1st 24 hrs. Nat. \_\_\_\_\_  
1st 24 hrs. after shot \_\_\_\_\_  
Gas \_\_\_\_\_ Cu. Ft.  
Dry Hole \_\_\_\_\_  
Abandoned \_\_\_\_\_

Date

SEP 3 1925

CHAS. L. SHERWOOD  
Scout

Greenwood

Map No. K16 KANSAS Sec. 22 Twp. 23 R. 12

Well No. 1 holl  
McKinnis + Parrish. Company

Contractor

COMPLETED

SECTION PLAT

		o	

Ft. from N. Line  
250  
Ft. from S. Line  
Ft. from E. Line  
250  
Ft. from W. Line

ABANDONED

Location -----

Rig up -----

Drilling and Remarks:

2op line 1798'  
Dry + abandon 20  
1835

RECORD

Cased \_\_\_\_\_ in., \_\_\_\_\_ ft.  
Sand \_\_\_\_\_  
Gas \_\_\_\_\_  
Oil \_\_\_\_\_  
Total Depth 1835

PRODUCTION

1st 24 hrs. Nat. \_\_\_\_\_  
1st 24 hrs. after shot \_\_\_\_\_  
Gas \_\_\_\_\_ Cu. Ft.  
Dry Hole   
Abandoned

Date

MAR 11 1926

CHAS. L. SHERWOOD  
Scout