


Greenwood
 Map No. K5 Sec. 24 Twp. 23 R. 12
 Well No. 1-H. Fletcher Farm
Prairie & John Stark Company

Ft. from N. Line

330 Ft. from S. Line

Ft. from E. Line

330 Ft. from W. Line

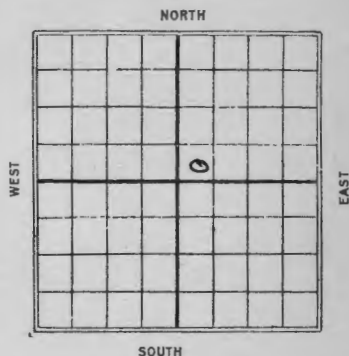

1926

Date REPORT

11/23 Loc

12/8 —

12/15 —

12/22 machine

12/30 same

1927

1/6 —

1/13 —

1/19 —

1/26 —

2/3 —

2/10 —

2/17 —

4/24 —

3/2 —

3/9 —

3/16 —

3/24 —

3/30 moving in machine


4/7 machine

4/13 Rigging up

4/20 —

4/27 —

Greenwood
 Map No. K5 Sec. 24 Twp. 23 R. 12
 Well No. 1-H. Fletcher Farm
Prairie & John Stark Company

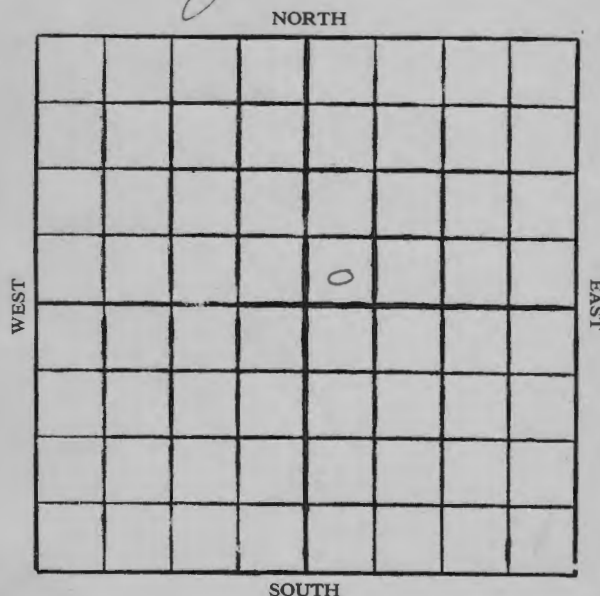
 Location
 Drilling Remarks

 Rig Up
 Drilling Remarks

RECORD

 Cased.....in.ft.
 Sand
 Gas
 Oil
 Total Depth.....

PRODUCTION

 1st 24 hrs. Nat.....
 1st 24 hrs. after shot.....
 Gas..... cu. ft.
 Dry Hole.....
 Abandoned.....

[illegible]

Sherwood
 16 KANSAS
 Map No. _____ Sec. *24* Twp. *23* R. *12*
 Well No. *1* *H. Fletcher*
Prairie & John Stark Company
 Contractor

COMPLETED

SECTION PLAT

Ft. from N. Line

330 Ft. from S. Line

Ft. from E. Line

330 Ft. from W. Line

ABANDONED

Location _____

Rig up _____

Drilling and Remarks:

*Top line 1693**1740' AFW*

RECORD

Cased _____ in., _____ ft.

Sand _____

Gas _____

Oil _____

Total Depth *1740'*

PRODUCTION

1st 24 hrs. Nat. _____

1st 24 hrs. after shot _____

Gas _____ Cu. Ft.

Dry Hole ☒Abandoned ☒

Date

JUN 22 1927

CHAS. L. SHERWOOD

192

Scout

Sherwood
 16 KANSAS
 Map No. _____ Sec. *24* Twp. *23* R. *12*
 Well No. *1* *H. Fletcher*
Prairie & John Stark Company
 Contractor

FIRST REPORTS

SECTION PLAT

Ft. from N. Line

330 Ft. from S. Line

Ft. from E. Line

330 Ft. from W. LineLocation ☒

Rig up _____

Drilling and Remarks:

RECORD

Cased _____ in., _____ ft.

Sand _____

Gas _____

Oil _____

Total Depth _____

PRODUCTION

1st 24 hrs. Nat. _____

1st 24 hrs. after shot _____

Gas _____ Cu. Ft.

Dry Hole _____

Abandoned _____

Date

NOV 23 1926

CHAS. L. SHERWOOD

192

Scout