


Kansas

Map No. _____ Sec. 2 Twp. 23 R. 12

Well No. 1 Frankhouser Farm

Simms Oil Company

NORTH

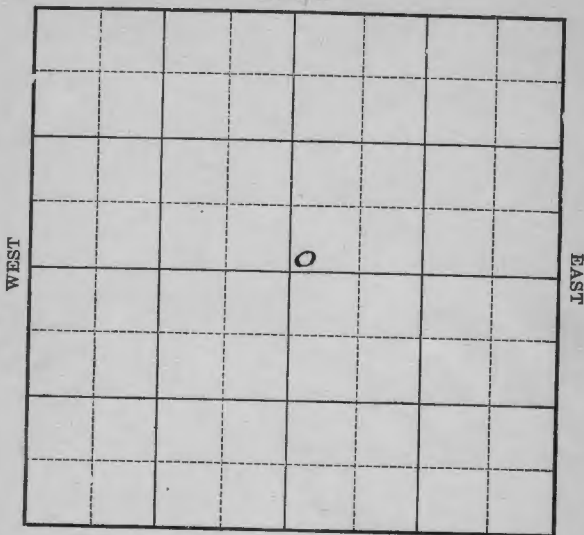

SOUTH

Location _____

Drilling Remarks:

Rig Up _____

Drilling Remarks:

RECORD

Cased _____ in. _____ ft.

Sand _____

Gas _____

Oil _____

Total Depth _____

PRODUCTION

1st 24 hrs. Nat. _____

1st 24 hrs. after shot _____

Gas _____ cu. ft.

Dry Hole _____

Abandoned _____

Map No. _____ Sec. 2 Twp. 23 R. 12

Well No. #1 Frankhouser Farm

Simms Oil Company


NORTH

_____ Ft. from N. Line

200 Ft. from S. Line

_____ Ft. from E. Line

200 Ft. from W. Line

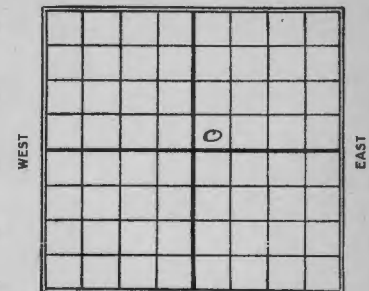

SOUTH

Date
1922

REPORT

5/21
7/22

Spudding
Prod 2380

Map No. 1-15 Sec. 2 Twp. 23 R. 12

Well No. 1-15-1

Company _____ Contractor _____

FIRST REPORT

SECTION PLAT

_____ Ft. from N. Line
_____ Ft. from S. Line
_____ Ft. from E. Line
_____ Ft. from W. Line

Location _____
Rig up _____

Drilling and Remarks:
Spudding

RECORD
Cased _____ in., _____ ft.
Sand _____
Gas _____
Oil _____
Total Depth _____

PRODUCTION
1st 24 hrs. Nat. _____
1st 24 hrs. after shot _____
Gas _____ Cu. Ft.
Dry Hole _____
Abandoned _____

Date MAY 21 1922
_____ 191 _____ M. A. BENEAR _____ Scout

Map No. 1-15 Sec. 2 Twp. 23 R. 12

Well No. 1-15-1

Company _____ Contractor _____

ABANDONED

SECTION PLAT

_____ Ft. from N. Line
300' Ft. from S. Line
_____ Ft. from E. Line
200' Ft. from W. Line

Location _____
Rig up _____

Drilling and Remarks:

RECORD
Cased _____ in., _____ ft.
Sand _____
Gas _____
Oil _____
Total Depth _____

PRODUCTION
1st 24 hrs. Nat. _____
1st 24 hrs. after shot _____
Gas _____ Cu. Ft.
Dry Hole _____
Abandoned 2380'

Date JUL 22 1922
_____ 191 _____ M. A. BENEAR _____ Scout