

WINZELER #1
OWNER: T.K. Simmons & D.M. Rhodes
CONTRACTOR: C. W. Cross

LOCATION: NE/c of SW/4 Sec. 12-23-12
Greenwood County, Kansas.
Drilling commenced February 2, 1927.
Drilling completed March 3, 1927.

D R I L L I N G R E C O R D

Soil	3	5	Red rock	5	990
Gravel	8	11	Shale black	22	1012
Clay	14	25	(Set 1012 feet 10" casing)		
Lime white	50	75	Lime white	2	1014
Red rock	20	95	Shale light	26	1040
Lime white	15	110	(1 bailer water)		
Shale gray	20	130	Lime white	75	1115
Lime white	10	140	Shale blue	5	1120
Shale white	25	165	Lime light	30	1150
Lime white	35	200	Shale blue	125	1275
Shale blue	125	325	Lime brown	5	1280
Lime gray	5	330	Shale light	12	1292
Shale black	10	340	Lime gray	21	1313
Lime white	35	375	Shale gray	42	1355
Shale gray	10	385	Lime gray	5	1360
Red rock	5	390	Shale blue	30	1390
Lime blue	25	415	(4 bailers water) (1390)		
Shale white	30	445	Lime white	10	1400
Lime blue	5	450	Shale blue	182	1582
Shale white	25	475	(Set 1582 feet 8 1/2" casing)		
Lime brown	10	485	Lime white	8	1590
Shale blue	133	618	Shale light	75	1665
Lime gray	7	625	Red rock	10	1675
Sand water	25	650	Shale light	95	1770
(7 bailers water)			Shale black	20	1790
Shale gray	2	652	Shale light	25	1815
(Set 652 feet 12 1/2" casing)			Lime MISSISSIPPI	70	1885
Shale gray	48	700	TD (Hole full water) (SLM)		1885
Lime white	25	725			
(3 bailers water)					
Shale blue	5	730			
Lime white	198	928			
Sand white	22	950			
(Hole Full water)					
Lime white	20	970			
Shale blue	15	985			

State of Kansas, County of Greenwood, ss:

Harry Horn, of lawful age, being first duly sworn on his oath deposes and says that he is Superintendent for T. K. Simmons and supervised the drilling of Winzeler #1.

That the above is a true and correct copy of the log of Winzeler #1 to the best of his knowledge and belief.

Subscribed and sworn to before me this 29 day of March, 1927.

John Daugherty
Notary Public.

My Commission expires

May 18, 1929.

WINZELER #1
OWNER: T. K. SIMMONS & D. M. RHODES
CONTRACTOR: C. W. Cross

LOCATION: NE/c of SW/4 Sec. 12-23-12
Greenwood County, Kansas
Drilling commenced February 2, 1927
Drilling completed April 9, 1927

CASING RECORD


12-1/2"	50#	Casing	652'
10"	40#	"	1012'
8-1/4"	28#		1582'
6-5/8"	20#		2170'

All Pipe pulled

Soil soft	0	5	Shale	1590	1665
Gravel soft	3	11	Red rock red	1665	1675
Clay hard	11	25	Shale light	1675	1770
Lime white hard	25	75	Shale black	1770	1790
Red rock Red soft	75	95	Shale light	1790	1815
Lime white hard	95	110	Mississippi Lime	1815	1885 HFV
Shale gray soft	110	130	T.D. 1885 S.L.M.		
Lime light hard	130	140			
Shale white soft	140	165	Winzeler #1 Continued		
Lime white hard	165	200			
Shale blue soft	200	325	Sand water	1815	1925
Lime gray hard	325	330	Lime	1825	1935
Shale black soft	330	340	Sand brown	1935	1985
Lime white hard	340	375	Lime	1985	2140
Shale gray soft	375	385	Shale blue	2140	2170
Red rock red soft	385	390	Lime	2170	2178
Lime blue soft	390	415	Shale blue	2178	2258
Shale white hard	415	445	Sand water	2258	2280 HF
Lime blue soft	445	450			
Shale white hard	450	475	T.D. 2280 S.L.M.		
Lime brown soft	475	485	dry and plugged		
Shale blue hard	485	618			
Lime gray soft	618	625			
Sand water white soft	625	650 7 BW			
Shale gray soft	650	700			
Lime white hard	700	725 3 BW			
Shale blue soft	725	730			
Lime white hard	730	928			
Sand water white	928	950 H.F.			
Lime white	950	970			
Shale blue	970	985			
Red rock red	985	990			
Shale black	990	1012			
Lime light	1012	1014			
Shale light	1014	1040 1 B.W.			
Lime white	1040	1115			
Shale blue	1115	1120			
Lime light	1120	1150			
Shale blue	1150	1175			
Lime brown	1275	1280			
Shale light	1280	1292			
Lime gray	1292	1313			
Shale gray	1313	1355			
Lime gray	1355	1360			
Shale blue	1360	1390 4 BW			
Lime white	1390	1400 at 1390			
Shale blue	1400	1582			
Lime white	1582	1590			

*Greenwood*Map No. *1/AN* Sec. *12* Twp. *22* R. *12*Well No. *1* *Wingzeler* Farm~~*H. J. Wilson*~~ Company

NORTH

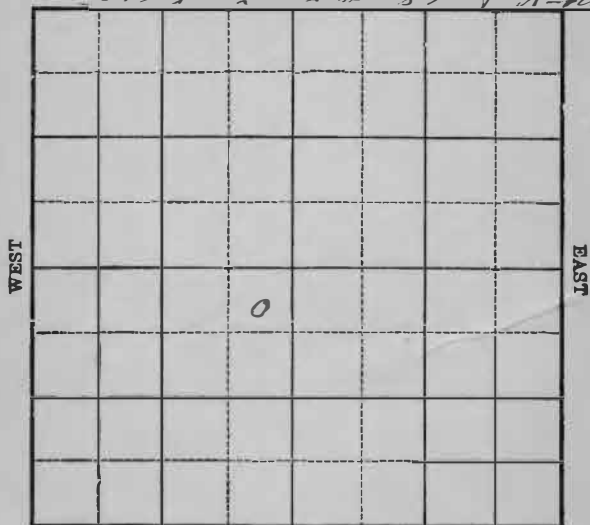

SOUTH

Location _____
Drilling Remarks _____Rig Up _____
Drilling Remarks _____

RECORD

Cased _____ in. _____ ft.

Sand _____

Gas _____

Oil _____

Total Depth _____

PRODUCTION

1st 24 hrs. Nat. _____

1st 24 hrs. after shot _____

Gas _____ cu. ft.

Dry Hole _____


Abandoned _____

*Greenwood*Map No. _____ Sec. *12* Twp. *23* R. *12*Well No. *1* *Wingzeler* Farm~~*H. J. Wilson*~~ Company*SIMMONS + Rhodes* NORTH*330* Ft. from N. Line

_____ Ft. from S. Line

330 Ft. from E. Line

_____ Ft. from W. Line

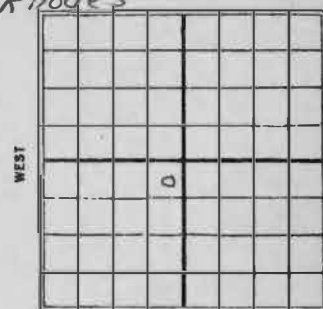


SOUTH

1916

Date

REPORT

*8/25 Location**8-31 machine**9/5* _____*9/22* _____*9/29 same**10/3 same**10/27 location only**11/11 same**11/17 same**11/23 machine. Rign. up**12/8 Spudding**12/15 Spudded + S.D.**12/22 same**12/30* _____*1921**1/6* _____*1/13* _____*1/19* _____*1/26* _____*2/3* _____*2/10 Dreg-750**4/17 " 675*

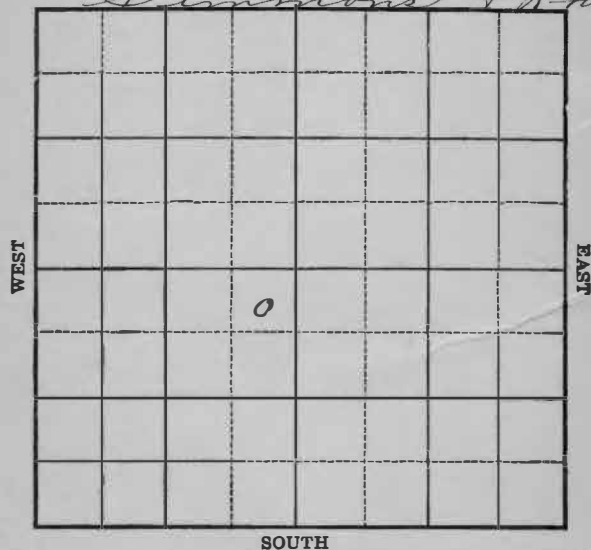Map No. 157N Sec. 12 Twp. 23 R. 12Well No. 1 Wingeler FarmH. J. Wilson CompanyGreenwood NORTH Summons & Rhodes

Location _____ Rig Up _____

Drilling Remarks _____

RECORD

Cased _____ in. _____ ft.

Sand _____

Gas _____

Oil _____

Total Depth _____

PRODUCTION

1st 24 hrs. Nat. _____

1st 24 hrs. after shot _____

Gas _____ cu. ft.

Dry Hole _____

Abandoned _____

2/24 - Drlg 1050

3/2 - " 1250

3/9 - no sand, top line 1816
1st. break 1840'
D. & A. 1885 - N. F. W.3/16 - drlg deeper
UR. 8 1/4" from 1575
to 1816. going to
second break3/24 - UR. 8" from 1575 to
1816 - T. D. 1885 -3/30 - Top line 1816 - first break
1840 - Drlg 1930 -4/7 - Top line 1816 - first break
1840 - Base line 2140
Setting 6" - 21724/13 - no sand - Top line 1816'
1st bk. 1840'
Base line 2140'
D. & A. 2280'

16 KANSAS

Map No.

Sec.

Twp.

R.


Well No.

1 Wingerdon
Simmons & Rhodes Company

FIRST REPORTS

Contractor

SECTION PLAT

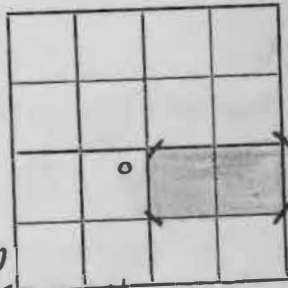

330

Ft. from N. Line

Ft. from S. Line

330

Ft. from E. Line

Ft. from W. Line

"going to 2nd break" OFFSET

Location

Rig up

Drilling and Remarks:

this well was Abd.

lost 1000s. But 400

4 1/2 8 1/4 from 1575-

to 1816 to drill deeper

RECORD

Cased in. ft.

Sand

Gas

Oil

Total Depth

PRODUCTION

1st 24 hrs. Nat.

1st 24 hrs. after shot

Gas Cu. Ft.

Dry Hole

Abandoned

Date

MAR 16 1927

CHAS. L. SHERWOOD

Scout

192

16 KANSAS

Map No.

Sec.

Twp.


R.

Well No.

1 Wingerdon
Simmons & Rhodes Company

COMPLETED

SECTION PLAT

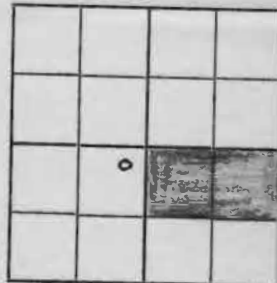

330

Ft. from N. Line

Ft. from S. Line

330

Ft. from E. Line

Ft. from W. Line

ABANDONED

"OFFSET"

Location

Rig up

Drilling and Remarks:

no sand

top line 1816

1st break 1840

DET 1885 AFW

RECORD

Cased in. ft.

Sand

Gas

Oil

Total Depth 1885

PRODUCTION

1st 24 hrs. Nat.

1st 24 hrs. after shot

Gas Cu. Ft.

Dry Hole ✓

Abandoned ✓

Date

MAR 9 1927

CHAS. L. SHERWOOD

Scout

192

16 KANSAS

Map No.

Sec.

Twp.

R.

Well No.

1 Winzeles
Simmons & Rhodes Company

Contractor

CORRECTION

330

Ft. from N. Line

Ft. from S. Line

330

Ft. from E. Line

Ft. from W. Line

SECTION PLAT

RECORD

Location

Rig up

Drilling and Remarks:

Chg ownership
to above.

Cased in., ft.

Sand

Gas

Oil

Total Depth

PRODUCTION

1st 24 hrs. Nat.

1st 24 hrs. after shot

Gas Cu. Ft.

Dry Hole

Abandoned

Date

OCT 27 1926

CHAS. L. SHERWOOD

Scout

16 KANSAS

Map No.

Sec.

Twp.

R.

Well No.

1 Winzeles
Simmons & Rhodes Company

Contractor

COMPLETED

SECTION PLAT

330

Ft. from N. Line

Ft. from S. Line

330

Ft. from E. Line

Ft. from W. Line

ABANDONED

Location

Rig up

Drilling and Remarks:

no bond
Top line 1816
1st line 1840
Base line 2140
Depth 2280

RECORD

Cased in., ft.

Sand

Gas

Oil

Total Depth 2280

PRODUCTION

1st 24 hrs. Nat.

1st 24 hrs. after shot

Gas Cu. Ft.

Dry Hole

Abandoned

Date

APR 13 1927

CHAS. L. SHERWOOD

192

Scout

Greenwood
 16 KANSAS
 Map No. 12 Sec. 23 Twp. 12 R.
 Well No. 1
H. J. Wilson
 Company
 Contractor

FIRST REPORTS

SECTION PLAT

330
 Ft. from N. Line

Ft. from S. Line

330
 Ft. from E. Line

Ft. from W. Line

	e		

Location ✓

Rig up

Drilling and Remarks:

RECORD

Cased _____ in., _____ ft.

Sand _____

Gas _____

Oil _____

Total Depth _____

PRODUCTION

1st 24 hrs. Nat. _____

1st 24 hrs. after shot _____

Gas _____ Cu. Ft.

Dry Hole _____

Abandoned _____

Date

AUG 25 1926

CHAS. L. SHERWOOD

Scout