


Map No. KANSAS Sec. 13 Twp. 23 R. 12^E
 Well No. 1- Souder Farm
Braden et al Company

NORTH

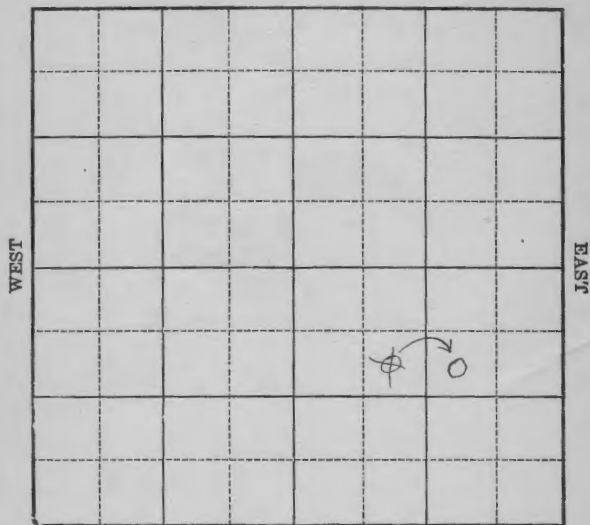

SOUTH

Location
Drilling Remarks


Rig Up
Drilling Remarks

RECORD
 Cased in. ft.
 Sand
 Gas
 Oil
 Total Depth

PRODUCTION
 1st 24 hrs. Nat.
 1st 24 hrs. after shot
 Gas cu. ft.
 Dry Hole
 Abandoned

Map No. KANSAS Sec. 13 Twp. 23 R. 12^E
 Well No. 1- Souder Farm
Braden et al Company

NORTH

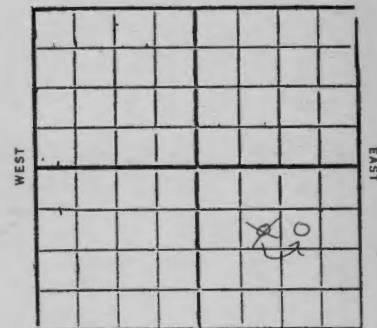

SOUTH

990 Ft. from N. Line

Ft. from S. Line

990 Ft. from E. Line

990 Ft. from W. Line

1931

Date

REPORT

3/11 Machine
 3/18 Mud 225'
 3/25 Drlg 475'
 4/11 " 950'
 4/18 SID 1300' set 6"
 4/15 Top line 1673
 T.D. 1715
 Dry & abandon

Greenwood
 16 KANSAS Sec. 13 Twp. 23 R. 12 E

Well No. 1 Sanders
 Braden et al Company

Contractor

CORRECTION

990 Ft. from N. Line

Ft. from S. Line

990 Ft. from E. Line

Ft. from W. Line

SECTION PLAT

Location

Rig up

Drilling and Remarks:

RECORD

Cased in, ft.

Sand

Gas

Oil

Total Depth

PRODUCTION

1st 24 hrs. Nat.

1st 24 hrs. after shot

Gas Cu. Ft.

Dry Hole

Abandoned

Date

APR 8 1931

192

CHAS. L. SHERWOOD

Scout

Greenwood
 16 KANSAS Sec. 13 Twp. 23 R. 12 E

Well No. 1 Sanders
 Braden et al Company

Contractor

SECTION PLAT

990 Ft. from N. Line

Ft. from S. Line

Ft. from E. Line

990 Ft. from W. Line

FIRST REPORTS

Location

Rig up

Drilling and Remarks:

Mach

RECORD

Cased in, ft.

Sand

Gas

Oil

Total Depth

PRODUCTION

1st 24 hrs. Nat.

1st 24 hrs. after shot

Gas Cu. Ft.

Dry Hole

Abandoned

Date

MAR 11 1931

S. J. LEWIS

Scout

Greenwood
 Map No. 16 KANSAS Sec. 13 Twp. 23 R. 12 E

Well No. 1 *Sanders*
Broden et al Company

Contractor

COMPLETE

SECTION PLAT

990 Ft. from N. Line

Ft. from S. Line

990 Ft. from E. Line

Ft. from W. Line

ABANDONED

Location

Rig up

Drilling and Remarks:

Jap Lim 1673

RECORD

Cased in, ft.

Sand

Gas

Oil

Total Depth 1715

PRODUCTION

1st 24 hrs. Nat.

1st 24 hrs. after shot

Gas Cu. Ft.

Dry Hole ☒Abandoned ☒

Date
 APR 15 1931

192 CHAS. L. SHERWOOD
 Scout