17

Kans S. 13 T. 23 S.,R. 10 E. W.

Greenwood County

Empire Gas & Fuel Company

Piatt #11 Farm

T.D.

Prs - 70 bbls

elation by

drilled 6/16 - 7/9/26

G.B.

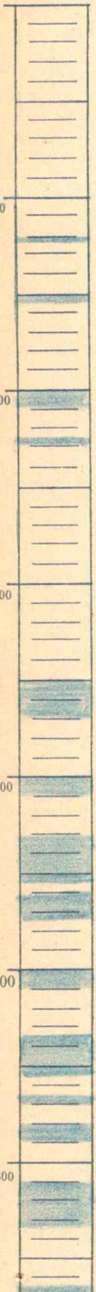

100
200
300
400
500
600

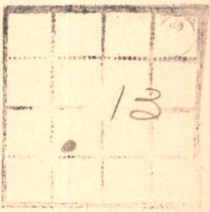

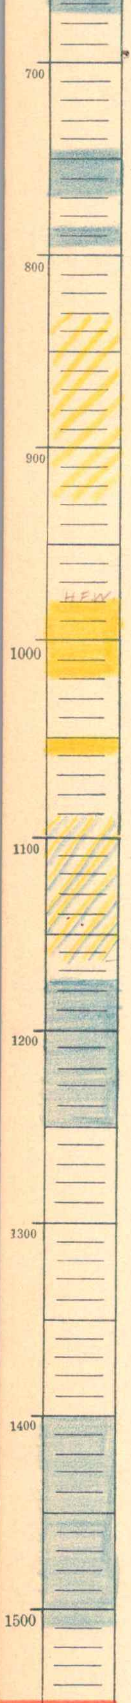
700
800
900
H.F.W.
1000
1100
1200
1300
1400
1500

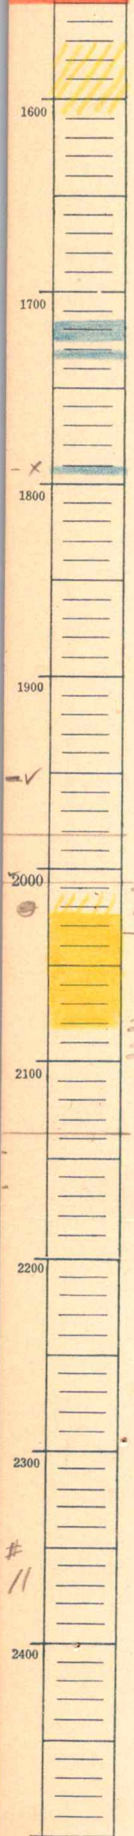
1600
1700
1800
1900
2000
2100
2200
2300
2400

-x 1790-95

2011
2033

22
49
71

2082
2087-T.O.

5-5-41

49

26
49
75

26

#11

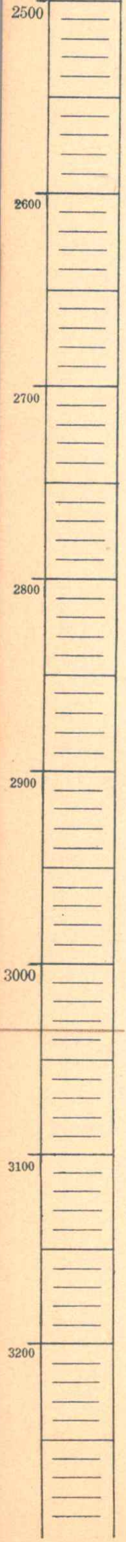
2500
2600
2700
2800
2900
3000
3100
3200