13-23-10E


Sec. 13 Twp. 23 Rge. 10

Farm Edwards No. 1

White Eagle Company

Elev. T. D.

Log No.

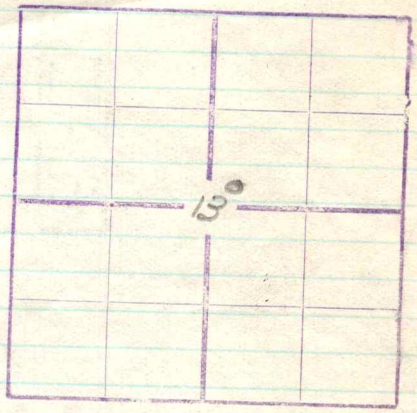

Drumm & Co. Kas.

9500

Surf-18
li-28
sh-35
sd-50
li-60
sd-70
li-72
sd-77
sdy li-90
sh-120
sd-135
li-140
sh-158
li-195
sh-205
li & sh-210
li-230
li-234
sh-237
li-250
mud-254
sd-275
li-285
sh-310
li-320
sh-375
li-382
li-410
sd-450
sh-456
li-475
sh-478
li & sh-485
li-502
sh-520
li-525
sd-535
li-565
sh-570
li-575
sh-580
li-595
sh-600
li-605
li & sh-610
li-635
sd-640
li-650
sd-668
sh-704
li-711
sh-724
sh & li-744
sh-759
li-769
sh-780
li-810
sh-814
li-820
sh-824
li & shll-830
li-845
sh-865
li-868
sh-985
li-1010
H_2O sd-1065
sh-1078
sdy li-1122
sh-1130
sdy li-1149
li-1197
sd-1205
li-1234
li-1270
li-1290
sh-1298
li-1303
sh-1335
sh-1415
li-1552
sh-1557
li-1575
sdy sh-1625
sh-1714
li-1715
li-1718
sd-1727
li-1742
sd-1790
sh-1795
li-1803
sh-1818
li & sh-1845
li-1865
sh-1950
li-1955
sh-1990
li & sh-2015
sh-2057
sdy sh-2070
Oil sd-2106
sh-2127 T.D. SLM.