

Greenwood Co., Kans.


Sec. 18 Twp. 23 Rge. 11

Farm Allen No. 5

Rogers & Bitler Company

Elev. T. D.

Log No. 9419

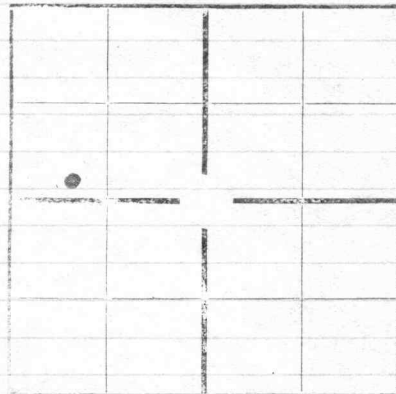

800' from W. line
200' " S. "
in NW 1/4

- soil 20
- sh 105
- ls 155
- sh 160
- ls 170
- sh 205
- ls 215
- sh 275
- ls 282
- sh 360
- ls 370
- sh 420
- ls 425
- sh 480
- ls 495
- sh 520
- ls 575
- sh 620
- ls 640
- sh 710
- ls 715
- sh 755
- ls 800
- sh 870

- sh 1820
- ls 1830
- sh 1840
- ss 1850
- sh 2026
- ss 2036
- sh 2081
- ss 2101
- sh 2137

Pay ss 2093 to 2101.

- sandy sh 880
- sh 940
- ls 950
- sh & ss 990
- water ss 1075 water
- sh 1080
- sandy ls 1090 water
- ls 1125
- sh 1138
- ls 1185
- sh 1195
- ls 1245
- sandy ls 1280
- sh 1300
- ls 1315
- sh 1410
- ls 1440
- sh 1443
- ls 1550
- sh 1555
- ls 1585
- sh 1620
- ss 1640 water
- sh 1700
- cave 1722
- ls 1730
- sh 1760
- ls 1770