


State Geological Survey
KANSAS DRILLERS LOG
 WICHITA, BRANCH

IMPORTANT
 Kans. Geo. Survey request
 samples on this well.

S. 25 T. 23 R. 21 ^E
 Loc. SW NE
 County Bourbon

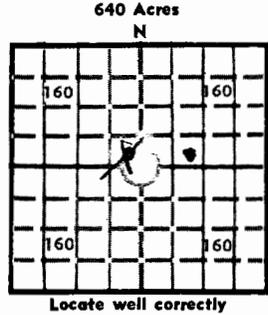

Elev.: Gr. _____
 DF _____ KB _____

API No. 15 - 20140
 County Bourbon Number

Operator Jackson Oil Co.

Address 219 S Ashby Chanute Kansas

Well No. #8 Lease Name Camp

Footage Location
 feet from (S) line 300' feet from (E) line 400'

Principal Contractor Dre Eastwood Geologist _____

Spud Date OCT 5 1973 Total Depth 642 P.B.T.D. _____

Date Completed OCT 25 1973 Oil Purchaser MID AMERICA

CASING RECORD

Report of all strings set — surface, intermediate, production, etc.

Purpose of string	Size hole drilled	Size casing set (in O.D.)	Weight lbs/ft.	Setting depth	Type cement	Sacks	Type and percent additives
<u>Production</u>	<u>6 1/4</u>	<u>2 3/8</u>	<u>41.60</u>	<u>642</u>	<u>NEET</u>	<u>75</u>	<u>5% Gel</u>

LINER RECORD

PERFORATION RECORD

Top, ft.	Bottom, ft.	Sacks cement	Shots per ft.	Size & type	Depth interval

Size	Setting depth	Packer set at
<u>2 3/8</u>	<u>642</u>	<u>642</u>

ACID, FRACTURE, SHOT, CEMENT SQUEEZE RECORD

Amount and kind of material used	Depth interval treated
<u>SAND 2000 lbs</u>	<u>642' - 652'</u>

INITIAL PRODUCTION

Date of first production Nov 1 1973 Producing method (flowing, pumping, gas lift, etc.) PUMPING

RATE OF PRODUCTION PER 24 HOURS	Oil <u>5 bbl</u>	Gas _____	Water _____	Gas-oil ratio _____
	bbls.	MCF	bbls.	CFPB

Disposition of gas (vented, used on lease or sold) _____ Producing interval (s) _____

INSTRUCTIONS: As provided in KCC Rule 82-2-125, within 90 days after completion of a well, one completed copy of this Drillers Log shall be transmitted to the State Geological Survey of Kansas, 4150 Monroe Street, Wichita, Kansas 67209. Copies of this form are available from the Conservation Division, State Corporation Commission, 3830 So. Meridian (P.O. Box 17027), Wichita, Kansas 66217. Phone AC 316-522-2206. If confidential custody is desired, please note Rule 82-2-125. Drillers Logs will be on open file in the Oil and Gas Division, State Geological Survey of Kansas, Lawrence, Kansas 66044.

Operator

JACKSON OIL CO

DESIGNATE TYPE OF COMP.: OIL, GAS, DRY HOLE, SWDW, ETC.:

Well No.

8

Lease Name

CAMP

S 25 T 23 R 2 L E

WELL LOG

Show all important zones of porosity and contents thereof; cored intervals, and all drill-stem tests, including depth interval tested, cushion used, time tool open, flowing and shut-in pressures, and recoveries.

SHOW GEOLOGICAL MARKERS, LOGS RUN, OR OTHER DESCRIPTIVE INFORMATION.

FORMATION DESCRIPTION, CONTENTS, ETC.	TOP	BOTTOM	NAME	DEPTH
Bertsville	642	648	Smp Tops	
			Bart 50	642
			Td	662

USE ADDITIONAL SHEETS, IF NECESSARY, TO COMPLETE WELL RECORD.



Cecil Jackson
Signature

Owner
Title

April 2, 1973
Date

KANSAS WELL COMPLETION REPORT

API No. 15 - 011 - 20140

Sec. 25 T. 23 R. 21 E.

Year well reported 1972

Spot _____


Company Jackson Oil Co.

County Bourbon

Farm & Well No. 8 Camp

Contractor Dee Eastwood

Please show location of well in section:

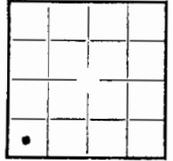

Date drilling comm. 10-2-72

Elev: Kelly Bushing _____

Date drilling comp. 10-7-72

Derrick floor _____

Ground _____

Field name CAMP

Hole was completed as: Dry _____; Oil well _____;

Electric or other logs were run: Yes _____ No _____

Water-flood producer _____; Gas well _____;

Well was cored: Yes No _____

Salt-water disposal _____; Other (name) _____.

Drill stem test run: Yes _____

No

INITIAL POTENTIAL OR PRODUCTION:

FORMATION TOPS

Bbbls oil/day 5, Bbbls water/day 0,

List below:

Thou cu ft gas/day _____.

Oil gravity 23 °API

Name of pay zone Bartlesville

Pay depth (bottom) 660

Net pay thickness 23'

Name of rock formation at total depth Cherokee

Total depth 660

Company purchasing oil or gas: Mid America

CASING

If OWWO*, give new footage drilled _____

* Old well drilled deeper

List:

9" cement to surface

10/15/1970

This well completion form is mailed to southeastern Kansas operators, because commercial reporting companies do not scout the area. Completed forms, driller's logs, electric logs, and other information submitted to us will be placed on open file for your use. Please complete form and mail in enclosed envelope to Margaret Oros, Head, Oil and Gas Division, State Geological Survey, Lindley Hall, Lawrence, Kansas 66044. Phone: 913-864-3852.

Minimum completion information will be used for reporting all wells completed in Kansas to the American Association of Petroleum Geologists' Committee on Statistics of Drilling. These statistics are published by the Oil and Gas Journal, American Association of Petroleum Geologists, U. S. Bureau of Mines, and others.

