
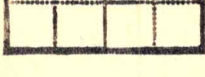


S. 21 T. 23 S., R. 11 E. W.
Greenwood County
Empire Company
Edwards #4 Farm
445 lbs T.D. 1st 24 hrs swab

relation by _____
e drilled 1-31-20-27

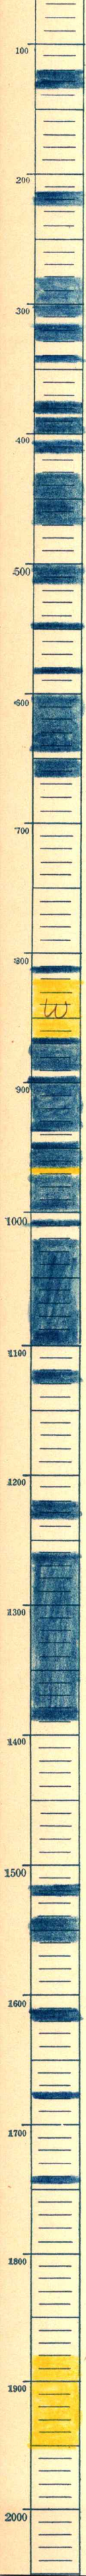

1880 T.S.

1952 T.D.