
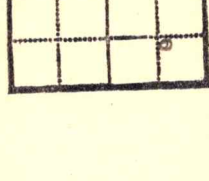


S. 21 T. 23 S., R. 11 E. W.
Greenwood County
Empire Company
Edwards 2-B Farm
335 fbs T.D.
shot 1609 to 1890-1955

relation by _____
e drilled 6-19 to 7-11-'29

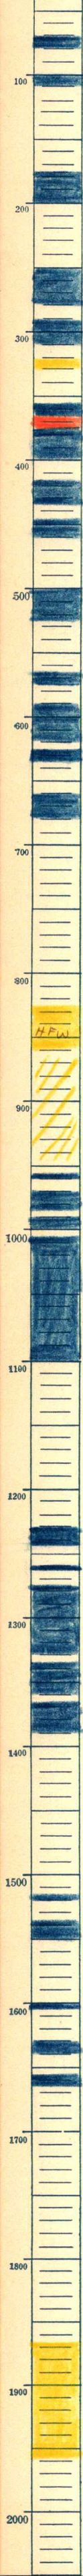

1866
1959
T.D. 1961