

S. 21 T. 23 S., R. 11 E. W.

Greenwood County

Lepas Company


Edwards, I-C Farm

100 fms T.D.

shot 90 gts 1276-97

lation by _____

drilled 11-26 to 12-28-28

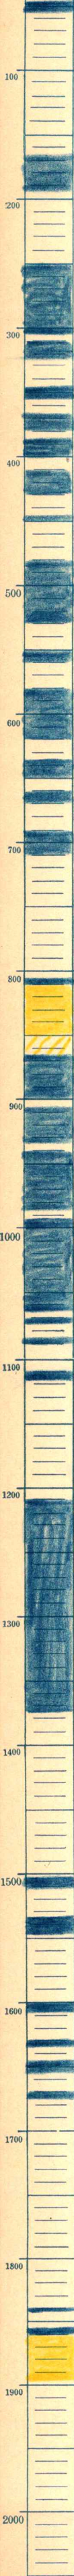

1840-42
1855
1860
1898
1900