Kans S. 23 T. 23 S.,R. 10 E. W.

Greenwood County

Mid. Ks. O. + G. Company

J. B. Allen #4 Farm

120 bbl T.D.

160 qts 2074-2100

elation by

drilled JB.

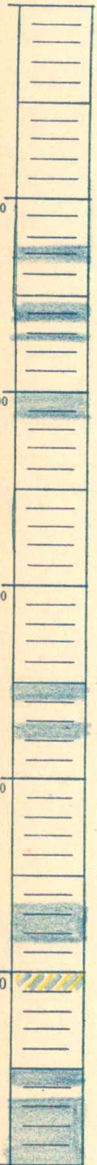

100
200
300
400
500

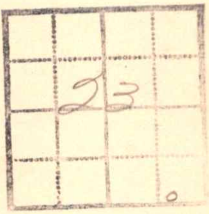

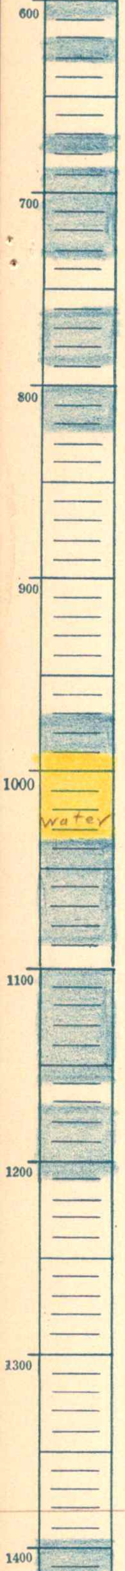
600
700
800
900
1000
water
1100
1200
1300
1400

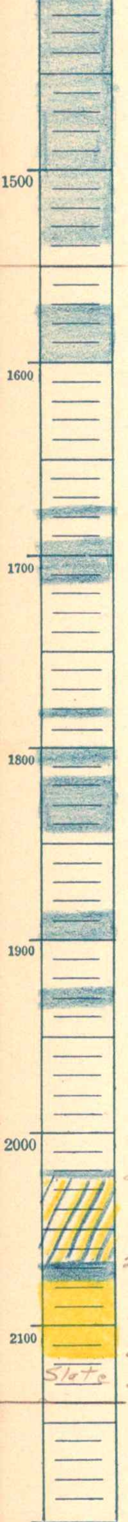
1500
1600
1700
1800
1900
2000
2100
Slots

1925-35

2020-23
shy li

2067-78 sh. lime. Plugged Back to 2100'

sd.

2117
dk. sh.
2128-T.D.

PB 2100

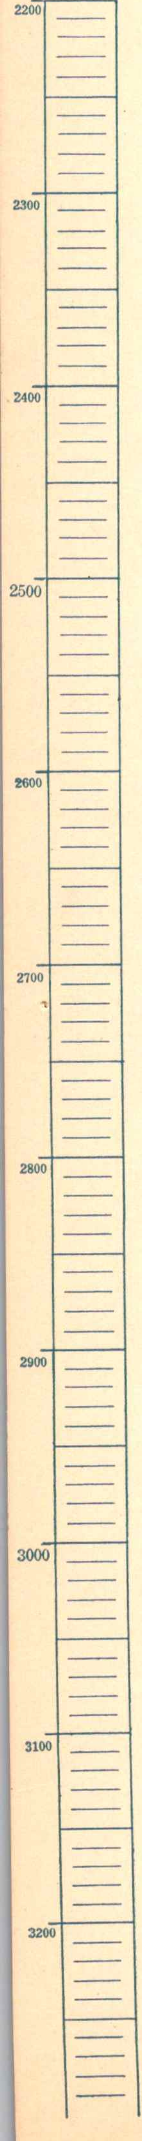
2200
2300
2400
2500
2600
2700
2800
2900
3000
3100
3200