

#8 - N. R.

26948


23-23-10E

23 140 235 10E
 Form Allen No. 9
 Mid-Kansas (Country)
 Date T. D.
 Log No.

#9

conn - 4-4-23
 comp - 5-21-23
 prod 125 bbls

15 - 96
 12 - 785
 10 - 1142
 8 - 1700
 6 - 2007

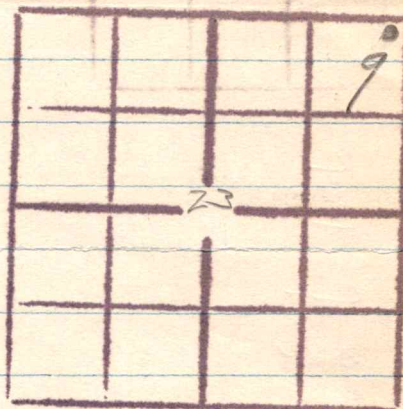

sh sf 0-80
 wtr 85
 3 95

sl sf 150
 L 170

sl wh 185

sh wh 215

sl 223

L hd 240

sl 260

L 270

sh 275

L 285

L hd 290

sh sf 330

sh it sf 370

L 395

sl sh 405

mud bl 430

sh bl 450

L 503

mud bl 520

sh 540

sh sf 545

L hd 580

sh bl 590

L 600

sl sh 608

L 643

sh 745

L 755

mud bl 775

L 780

mud bl 785

sh wh sf 795

sl hd 800

sh bl med 809

sh wh sf 815

L hd 835

sl gr sf 905

sh 970

sh dk sf 980

L hd 985

wtr 1035

sh 1060

sh wh hd 1065

sh bl sf 1070

sh et hd 1075

3 1100

sl sh sf 1105

sh bl hd 1108

L wh 1118

sh 1120

sl sh sf 1140

sh wh 1142

L 1165

L hd (with 1215) 1230

L hd 1292

sh bl sf 1335

sh 1380

sh bl sf 1400

over

23-23-10 E

L wh hd	1445		
L " "	1475	fwtr 1465-70)	
L	1515		
sh blk sf	1520		
L	1558		
sh bl sf	1563	oil S sf	2030
L	1570	sh blk sf	2032
sh et sf	1585	sf "	2035
sdsh "	1670	blks	2041
sh bl sf	1675	oil S Ben sf	2095
sh blk sf	1690	S	2108
L hd	1695	break	2112 + D
sh et sf	1705		
L wh hd	1710		
sdsh sf	1720		
L wh hd	1735		
sh	1785		
sdsh sf	1795		
sh bl "	1810		
L wh hd	1815		
sh bl sf	1825		
L wh hd	1845		
sf	1852		
S oil	1860		
sh sf	1882		
sh dk sf	1897		
sh bl "	1927		
sh et	1940		
sh dk	1965		
sh et	1985		
sh bl sf	1999		
sh	2002		
sdsh	2005		
" " sf	2015		