
23-23-10E

#1

26942

Sec. 23 Twp. 23S Rge. 10E
Farm L. Scott No. 1
Mid-Kansas Company
Elev. ..... T. D. 2119
Log No.

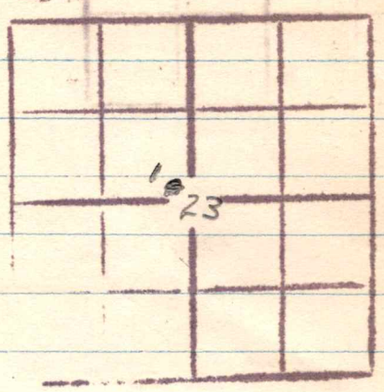


comm'd - 12-14-22
comp 1-27-23
prod. 35 bbls

12" - 216
10 - 947
8 - 1207
6 - 1695
5 - 2037

sh 0-10
L 20
sh 70
Swtr 90
sh 125
L 150
shale 170
L 180
sh 200
L 210
sl 215
L 245
sl 300
L 315
sl 365
L 380
sl 450
L 500
sl 540
L 555
sl 590
L 610
sh 660
L 685
~~mud~~ 695
L 710
sl 735
L 830
sl 985
sd L 1000
S 1050
sl 1070
S 1090
L 1105
sh 1120
L 1165
sl 1170
L 1275
sl 1365
S with 1390
L 1450
L 1540
S 1545
L 1550
sl wh 1565 HFW.
sl gr 1600
S 1615
sl 2067
ils 2106
Break 2109
S wtr 2117 TD PB 2106