

Burkett #2
 Sec. 24-23-10
 Greenwood County, Ks.


42161 24-23-10E

Nye et al

Loc.- SE NE NW

Dr. Comm.- Oct. 7, 1922
 Dr. Comp.- Oct. 27, 1922

Init. Prod.- 150 bbls.
 Elev.-

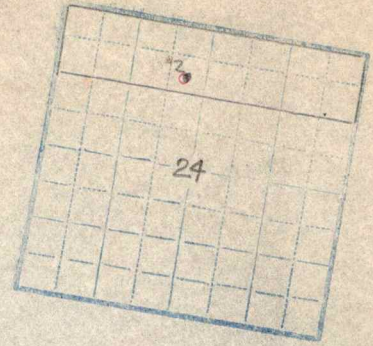

LOGGING RECORD

12 1/2" 127'
 10" 1000'
 8 1/2" 1254
 6 5/8" 2032'

Soil soft	18	18	Lime hard	5	1795
Slate soft	117	135	Slate soft	10	1805
Lime hard	7	142	Broken lime hard	40	1845
Slate soft	13	155	Shale soft	125	1970
Lime hard	6	161	Lime hard	15	1985
Slate soft	34	195	Shale soft	30	2015
Broken lime hard	40	235	Sand soft	15	2030
Slate soft	65	300	Broken slate soft	50	2080
Lime hard	15	315	Sand soft	40	2120
Slate soft	95	410			
Lime hard	15	425	Little water at 430		
Slate soft	115	470	1/2 bailer water at 580		
Lime hard	10	480	Hole full water at 1055		
Slate soft	80	560	1 bailer of water at 1430		
Sand soft	20	580	1 bailer of water at 1480		
Slate soft	20	600	1/2 bailer of water at 1510		
Lime hard	20	620	Dry sand at 2030		
Slate soft	20	640	Top of sand at 2080		
Lime hard	15	655	Total Depth 2120'.		
Slate soft	15	670			
Lime hard	245	915			
Slate soft	115	1030			
Sand soft	35	1065			
Broken lime hard	95	1160			
Lime hard	120	1280			
Slate soft	140	1420			
Lime hard	100	1520			
Slate soft	10	1530			
Lime hard	40	1570			
Slate soft	130	1700			
Lime hard	7	1707			
Slate soft	25	1730			
Lime hard	20	1750			
Slate soft	40	1790			

Extra