26-23-11E


Sec. 26 Twp. 23 Rge. 11

Farm Ellis No. 1

Company

Elev. T. D.

Log No. 9453

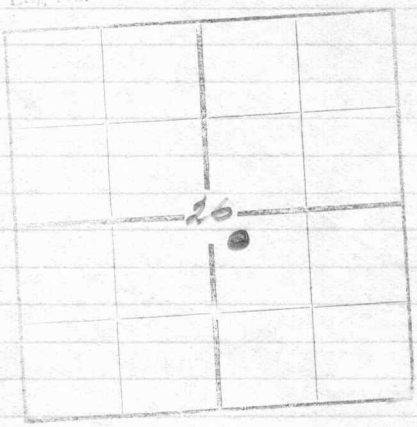

Gemmrd Co, Kas.

Soil - 7
li - 25'
sh - 80
li - 90
sh - 150
li - 160
sh - 240
li - 265
sh - 270
li - 285'
sh - 300
li - 305
sh - 325'
li - 340
sh - 355'
li - 365'
sh - 400
li - 410
sh - 420
li - 430
sh - 465'
li - 475'
sh - 530
li - 560
sh - 575'
li - 605'
sh - 615'
li - 635'
sh - 670
li - 675'
sh - 710
li - 725'
sh - 845'
li - 850
sd - 890 H.F.W.
sh - 915'
li - 940
sh - 945'
li - 970
sh - 975'
li - 985'
sh - 990
li - 1075'
sh - 1220
li - 1400
sh - 1505'
li - 1540
sh - 1590

li - 1605'
sh - 1625'
li - 1675'
sh - 1775
sd - 1785'
sdysh - 1805'
sh - 1875'
sd - 1880
sh - 1917
sd - 1932 Pay.
sh - 1952 5L.M.