
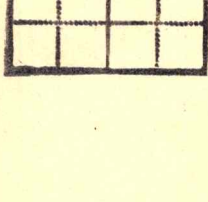


S. 27 T. 23 S., R. 11 E. W.
Greenwood County
J. K. Simmons Company
Ellis # 1-B Farm
Est. 250 bbls T.D.
 Drilled by _____
 Drilled 12-7 to 12-24-'29

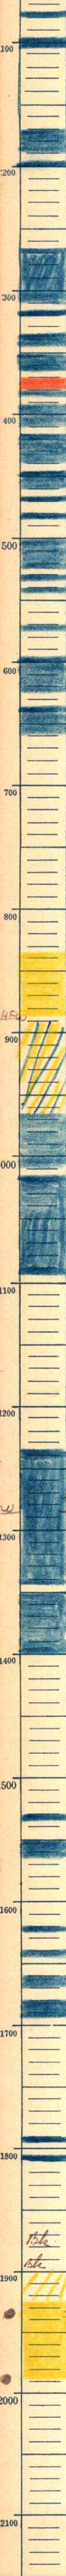

885 HFW

1275 } 1 1/2 BW
 1285 }

1900
 1924
 1934 1st oil
 1938 1st free oil
 oil sand
 1988 T.D.