


#13


Comm - 11-20-24
Comp 1-7-25
Prod. 235 bbls.

15" 31'
12-1122
10-1382
8-1928
6-2280

31 10E 235
from Martindell 13
Mid-Kansas Company
Elev. T.O.
Log No.

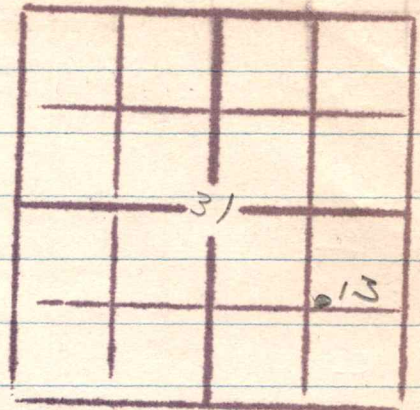

soil	0-10		
sl	15		
L	20		
sl	40	sl	670
L	50	L	710
sl	70	sl	720
L	80	L	730
sl	85	sl	735
L	95	L	745
sl	140	sl	775
L	150	L	795
sl	175	sl	800
L	185	L	805
sl	260	sl	815
L	270	L	830
sl	290	sl	855
L	295	L	885
sl	330	sl	910
L	335	L	930
sl	360	sl	975
L	370	L	985
sl	395	sl	1000
L	405	L	1025
sl	430	sl	1030
L	460	sl	1035
sl	500	sl	1040
L	505	L	1070
sl	535	sl	1095
L	550	S	1114
sl	585	sl	1250
L	590	L	1255
sl	595	S	1300
L	620	sl	1315

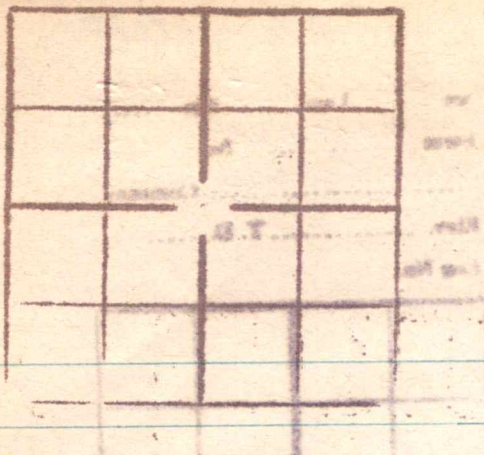

31-23-10E

L	1340
sl	1350
L	1525
sl	1625
L	1800
sl	1925
sl	1950
L	1960
sl	2020
sl	2030
L	2040
sl	2050
L	2070
sl	2110
sh	2180
sl	2220
sh	2286
oils	2371 + ID