

Butler County, Kansas


Drilling commenced Feb. 10 1920
Drilling completed Mar. 27 1920

Production : 150 bbls.

Quick sand	80
1 B.W. pr hr.	70
sandy lime	145
slate	165
lime	175
slate	195
lime and shelly	280
lime and slate	370
slate	375
lime and shell	435
shelly	470
lime and shale	555
3 B.W. pr hr	500
shale	575
dark slate	645
white slate	675
lime and shale	750
sand	755
shale and lime	800
brown sand	830
lime	855
slate	860
lime	870
slate	880
lime	900
water	885
sl te	1015
lime	1035
slate	1060
lime	1080
slate	1115
lime	1165
lime	1165
slate	1190
lime	1380
shale	1415
lime	1455
2 b.w.	1435
slate	1460
lime	1500
slate	1505
lime	1515
slate	1530
sand and wtr.	1540
shell	1544
lime	1550
slate	1630
lime	1640

H.F.W.

Sec. 29 Twp. 23 Rge. 4
Farm Ferrier No. 3
Pure Company
Elev. T. D.
Log No. 11650

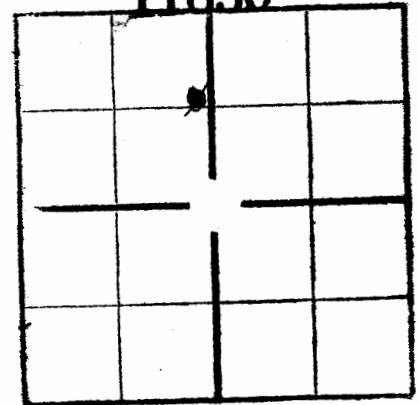

Slate	1660
lime	1685
slate	1725
lime	1850
sl re	1965
lime	2140
slate	2185
lime	2200
slate	2230
lime	2245
slate	2255
lime	2315
sh te	2378
top of sand	2383
water	2384
Total depth	2384'

Est 24 hrs. well made 150
bbls. of oil and 75 bbls. of
water pumped off in 12 hrs.

Cg. Rkd.

20"	38
15 $\frac{1}{2}$ "	146
12 $\frac{1}{2}$ "	835
10	1544
8 $\frac{1}{4}$ "	2135
6-5/8	2378
3	2395

Map No. K14 Sec. 29 Twp. 23 R. 4
Well No. 3 Ferrier
Ohio Cities Gas Company
Contractor

SECTION PLAT



1120 Ft. from N. Line
Ft. from S. Line
200 Ft. from E. Line
Ft. from W. Line

Location
Rig up
Drilling and Remarks:

Spud

RECORD
Cased in. ft.
Sand
Gas
Oil
Total Depth
PRODUCTION
1st 24 hrs. Nat.
1st 24 hrs. after shot
Gas Cu.
Dry Hole
Abandoned


Date

2/9 1920

Pyle

Map No. K14 Sec. 29 Twp. 23 R. 4
Well No. 3 Ferrier
Ohio Cities Gas Company
Contractor

SECTION PLAT

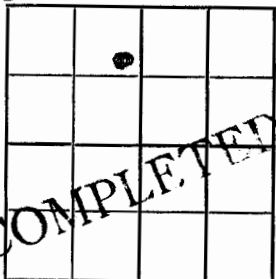

1120 Ft. from N. Line
Ft. from S. Line
200 Ft. from E. Line
Ft. from W. Line

Location
Rig up
Drilling and Remarks:

67 bbls Oil
75 bbls Water

RECORD
Cased in. ft.
Sand 2378-84
Gas
Oil
Total Depth
PRODUCTION
1st 24 hrs. Nat.
1st 24 hrs. after shot
Gas Cu. Ft.
Dry Hole
Abandoned


Date

3/29 1920

Pyle

Scout

Map No. Sec. 29 Twp. 23 R. 4
Well No. 3 Ferrier Farm
Ohio Cities Gas Co Company

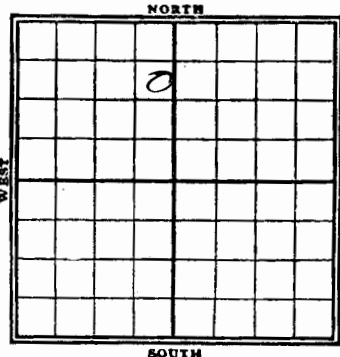

1120 Ft. from N. Line
Ft. from S. Line
200 Ft. from E. Line
Ft. from W. Line

REPORT **FIRST REPORT**
1920
2/9 Spudding
16 Oil 400
23 Oil 1040
3/1 Oil 1525
8 ✓ 1950
15 ✓ 2270
29 2378'-84' 67 bbls Oil
75 ✓ Water