

Butler County, Kansas.

Drilling commenced Feb. 26, 1920
 Drilling completed Apr. 5, 1920

Production - 100 bbls.

red clay	40
lime	60
slate	105
shale	115
white slate	140
sand	150
sand and shells	155
brown shale	165
slate	405
red rock	420
lime	435
slate	470
lime	500
slate	510
lime	550
slate	660
lime	670
slate	835
lime	838
slate	855
lime	860
slate	1010
lime	1030
slate	1135
lime	1175
slate	1195
lime	1230
slate	1235
lime	1250
slate	1290
lime	1305
slate	1340
lime	1390
slate	1415
lime	1465
slate	1470
lime	1530
slate	1555
lime shells	1675
slate	1730
lime	1850
shale	1855
slate	1940
lime	1995
slate	2005
lime	2030
slate	2075


lime	2130
blue shale	2140
slate	2375
white shale	2384
sand	2386

2 B.W. (2 B.W.) 470
 showing of oil casing record: 20055

15 1/2"	155'
12 1/2"	851
10	1542
8 1/4"	2152
6 5/8"	2396
3	2398'

Map No. K14 Sec. 29 Twp. 23 R. 4
Well No. 4 Ferrer Farm
Ohio Cities Gas Company

200
700 Ft. from N. Line
1120 Ft. from S. Line
1120 Ft. from E. Line
Ft. from W. Line

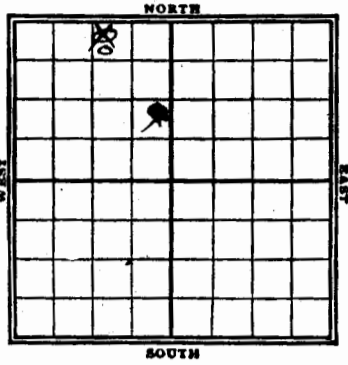

Days	REPORT	FIRST REPORT
2/5	Limbs at Ground.	
16	Rig	
23	Tools	
3/1	Qty. 100'	
8	600	
15	✓ 1305	
26	✓ 1915'	
29	✓ 2210	
4/12	land 2384-86	200 bbls

COMPLETED

Map No. K14 Sec. 29 Twp. 23 R. 4
Well No. 5 Ferrer Company
Ohio Cities Gas Contractor

200 Ft. from N. Line
Ft. from S. Line
1120 Ft. from E. Line
Ft. from W. Line

SECTION PLAT



Location
Rig up
Drilling and Remarks:

J.O.H

RECORD
Cased in. ft.
Sand
Gas
Oil
Total Depth

PRODUCTION
1st 24 hrs. Nat.
1st 24 hrs. after shot
Gas Cu. Ft.
Dry Hole
Abandoned

Date

191

Pyle


Scout

P O & G Form P-203-6-17-500 Books

Sec. 29 Twp. 23 Rge. 4
Owner Ohio Cities Gas
Farm Ferrer Well No. 4

Contractor
Feet from lines, N. 200 E. 1120 S. W.

Casing used
15 1/2 ft.
12 1/2 ft.
10 ft.
8 1/4 ft.
6 3/8 ft.
5 3-16 ft.

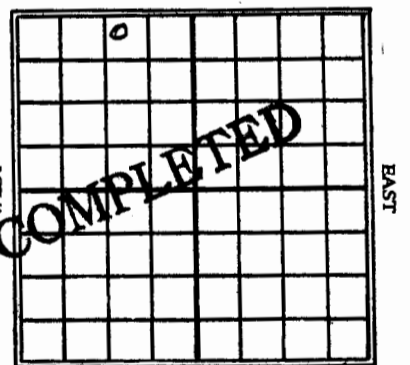


Location
Rig
Drilling at ft. Fishing at ft.
Total Depth Completed
1st 24 Hrs. Nat. 200 bbls Producing
1st 24 Hrs. Shot Dry Hole
Gas Cu. Ft. Abandoned
Sands - give name and depth. Top 2384 Bottom 86

Map No. K14 Sec. 29 Twp. 23 R. 4
Well No. 4 Ferrer Company
Ohio Cities Gas Contractor

200 Ft. from N. Line
Ft. from S. Line
1120 Ft. from E. Line
Ft. from W. Line

SECTION PLAT

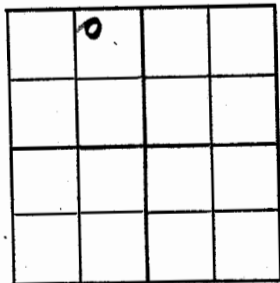

Location
Rig up
Drilling and Remarks:
Tools

RECORD
Cased in. ft.
Sand
Gas
Oil
Total Depth

PRODUCTION
1st 24 hrs. Nat.
1st 24 hrs. after shot
Gas Cu. Ft.
Dry Hole
Abandoned

Change
from No 5 to 4

Date

2/23 1920

Pyle Scout

Date of Report
Reported by

4/12

Pyle