


Butler County, Kansas.

Commenced Mar. 23, 1920
 Completed Apr. 28, 1920
 Production - 70 bbls.

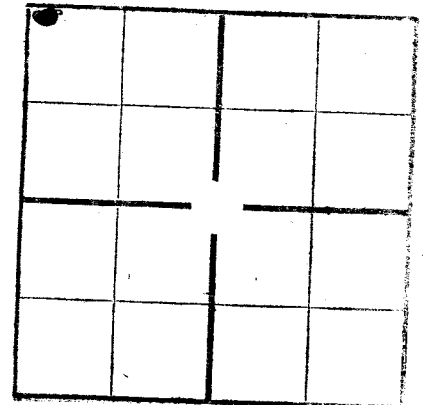

Soil	6		
slate	30		
gravel	35		
lime	45		
slate	65		
lime	90		
slate	110		
lime	125		
sandy lime	145		
sand	155	sand	1570
slate	160	slate	1585
lime	170	sandy lime	1590
slate	175	slate	1625
lime	195	lime	1649
slate	215	shale	1680
red rock	220	lime	1690
lime	225	slate	1740
slate	235	lime	1820
lime	265	shale	1835
slate	300	lime	1850
lime	360	shale	1990
red shale	375	lime shells	2070
lime	390	sand	2080
black shale	410	lime	2150
lime	440	shale	2155
slate	500	slate	2195
lime	520	lime	2220
slate and shells	610	slate	2245
red rock	630	lime	2260
lime	640	shale	2268
blue shale	660	lime	2315
shale and shells	690	red rock	2320
shale and shells	785	shale	2398
sand	792	sand	2401
slate	845		
lime	920	Little H ₂ O	505
slate	975		
shells and slate	1175	Water	1570
slate	1195	little wtr.	1760
lime and slate	1320	Little oil	1075
slate	1350	2 b.w.	2100
lime	1400		
slate	1435	15 1/8"	Csg. Rkd. 142'
lime	1440	12 1/2"	847
slate and lime shells	1565	10"	1647
		8 1/4"	2208
		6 5/8"	2415

