

BUTLER COUNTY, KANSAS


Drilling commenced Aug. 12, 1920
 Drilling completed Sept. 11, 1920
 Production - 1st 24 hrs. 20 bbls.
 2nd 24 hrs. 15 bbls.

Soil	5
red clay	20
gravel & sand	30
lime	160
shale	170
lime	195
shale	280
lime	320
shale	335
lime	370
shale	395
slate	425
lime	560
2 b.w.	520
shale	865
lime	920
shale	1020
lime	1060
shale	1100
lime	1400
shale	1425
lime	1460
shale	1530
sand	1545
slate	1555
shale	1600

lime	1650
shale	1850
shale	1960
lime	2150
shale	2185
lime	2188
shale	2195
lime	2210
shale	2393
oil sand T.B.	2395

5 b.w.	1540
4 b.w.	1820
showing oil	2025
Csg. Rkd.	
20"	32'
12 $\frac{1}{2}$ "	163
10"	870
8 $\frac{1}{4}$ "	1600
6 5/8"	2195
5 3/16"	226

Sec. 29 Twp. 23 Rre. 4
 Farm. Ferrier No. 10
 Pure Company
 Elev. T. D.
 Log No. 11645

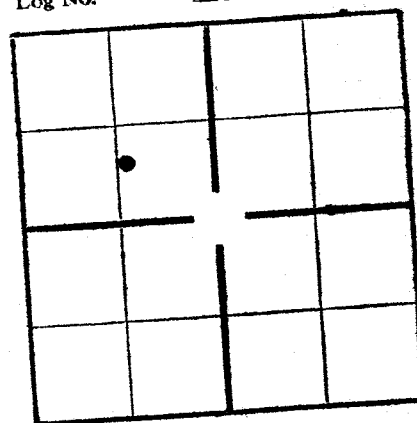


Map No. K 14 Sec. 29 Twp. 23 R. 4Well No. 10 Farrier FarmOhio Cities Gas Company
Pure Oil

Ft. from N. Line

1040 Ft. from S. Line1120 Ft. from E. Line

Ft. from W. Line

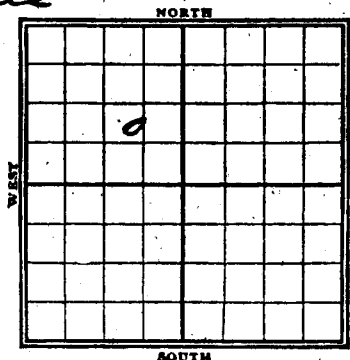

Date

REPORT

FIRST REPORT


6/31 Rig up.
 6/17 Rig
 15
 22 Spud
 28 385
 7/13 10" @ 1550
 24 Dry @ 2150
 26 1st 24 hrs. 2200'
 7/2
 8/14 Skidding
 16 Dry 156'
 9/16 2391-92-25 bbls oil
 300 bbls water

Form 26-1M-4-19-Mid-West

Map No. K 14 Sec. 29 Twp. 23 R. 4Well No. 10 Farrier Company

Contractor

SECTION PLAT

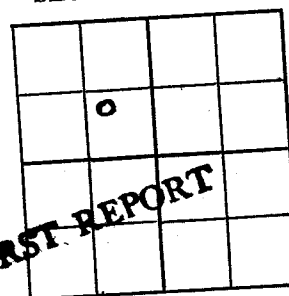

Ft. from N. Line

1040 Ft. from S. Line1120 Ft. from E. Line

Ft. from W. Line

Location

Rig up ☒

Drilling and Remarks:

RECORD

Cased _____ in., _____ ft.

Sand _____

Gas _____

Oil _____

Total Depth _____

PRODUCTION

1st 24 hrs. Nat. _____

1st 24 hrs. after shot _____

Gas _____ Cu. Ft.

Dry Hole _____

Abandoned _____

Date

5/311920

Pyle Scout

Form 26-1M-4-19-Mid-West

Map No. K 14 Sec. 29 Twp. 23 R. 4Well No. 10 Farrier Company

Contractor

SECTION PLAT

Ft. from N. Line

1040 Ft. from S. Line1120 Ft. from E. Line

Ft. from W. Line

CHANGE LESSEE NAME

Location

Rig up

Drilling and Remarks:

10" @ 1550

RECORD

Cased _____ in., _____ ft.

Sand _____

Gas _____

Oil _____

Total Depth _____

PRODUCTION

1st 24 hrs. Nat. _____

1st 24 hrs. after shot _____

Gas _____ Cu. Ft.

Dry Hole _____

Abandoned _____

Date

7/131920

Pyle


Scout

Form 26-1M-4-19-Mid-West

Map No. K 14 Sec. 29 Twp. 23 R. 4Well No. 10 Farrier Company

Contractor

SECTION PLAT

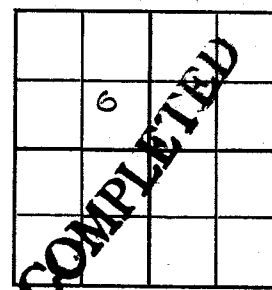

Ft. from N. Line

1040 Ft. from S. Line1120 Ft. from E. Line

Ft. from W. Line

Location

Rig up

Drilling and Remarks:

25 bbls oil
 300 bbls water

RECORD

Cased _____ in., _____ ft.

Sand 2391-92

Gas _____

Oil _____

Total Depth _____

PRODUCTION

1st 24 hrs. Nat. _____

1st 24 hrs. after shot _____

Gas _____ Cu. Ft.

Dry Hole _____

Abandoned _____

Date

9/141920

Pyle