


WHITE EAGLE OIL AND REFINING COMPANY'S WELL #1  
SUPERNAUGH, 4-23-4 Butler County,  
Elbing Field. Drilled June  
28th to Aug.13.1919.

Drilled By C.J.Skirvin

From	to	feet	Formation
		3	soil
3		20	red rock
20		45	lime
45		80	lime
80		95	red rock
95		110	lime
110		115	shale
115		145	lime soft
145		245	lime
245		260	red rock
260		280	shale
280		345	lime
345		360	red rock
360		375	shale
375		400	lime
400		425	slate
425		475	lime
475		500	red rock
500		525	lime
525		545	shale
545		565	slate
565		600	lime
600		615	slate
615		625	lime shell
625		630	slate
630	670	<del>630</del>	lime
670		690	slate
690		700	lime
700		720	slate
720		725	lime
725		735	slate
735		765	red rock
765		815	blue slate
815		820	slate
820		830	lime
830		860	slate
860		870	lime
870		890	slate
890		920	slate
920		975	lime
975		1010	lime
1010		1205	slate
1105		1120	lime
1120		1180	slate
1180		1210	lime
1210		1260	slate
1260		1300	lime
1300		1315	slate
1315		1325	lime
1325		1355	slate
1355		1460	lime
1460		1500	slate
1500		1570	lime
1570		1725	slate
1725	1750	1750	lime
1750		1775	slate
1775		1790	lime
1790		1825	slate oil
1825		1845	lime showing
1845		1875	oil sand
1875		1900	lime
1900		1945	lime
1945		2000	lime
2000		2008	oil sand
2008		2025	oil sand.

From to Feet Formation.

4-23-4E  
Supernaugh No. 1  
White Eagle  
T. D. 2025  
Log No.

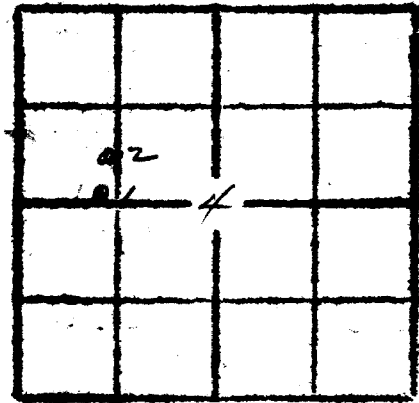

IP100.

steel line 2025.