


Row *S. 4* T. *23* S., R. *11* E.
Greenwood County
Phillips Company
Cragan # *3* Farm
 T.D.

Pro-Dry
 Drilled by
 drilled *5-5 to 5-21-26*
G.B.

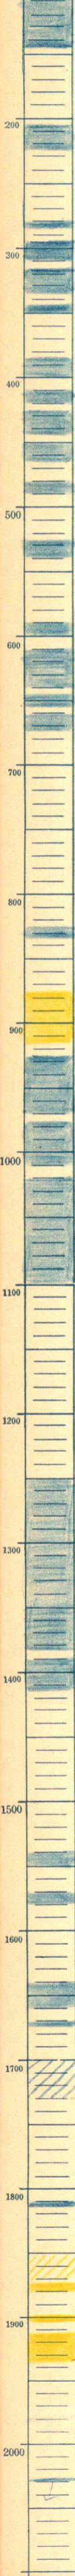

1700
1730

1850-70
1873-80
1889-1904
1911
1937

2028
T.D. 2028