

GEOLOGICAL DEPARTMENT
 SOUTHWESTERN GAS COMPANY

INDEPENDENCE, KANSAS

5-23-11E *PL*

LOG OF WELL

Company Tidal Oil Co. Farm R.R. Seeley Well No. 2
 State Kansas County Greenwood S. 5 T. 23 S R. 11 E
 Commenced Drilling 3-10-23 Completed 4-4-23 Elev. _____
 Shot _____ Qts. from _____ to _____ I. P. _____ R. P. _____
 Casing: 645' 1 1/2" Casing: 990' 1 1/2" Casing: 1662' 8 1/2"
 Casing: 1927' 6-5/8" Casing: _____ Casing: _____
 Tubing _____ Caged at _____ Packer at _____
 Contractor _____


soil	4
shale	35
lime	37
shale	50
shale	100
lime	106
shale	215
lime	235
shale	320
lime	330
shale	470
lime	530
shale	625
lime	660
shale	780
lime	845 HW
SAND	940
slate	967
lime	1242 ceiling
shale	1570
slate	1580
lime	1690
slate	1631
lime	1651
shale	1927
top sand	1927
oil showing	1947-1960 pay sand
bottoms	1984

incorrect,

Greenwood Co., Kans.

S-23-11E
Sec. 5 Twp. 23 Rge. 11
Farm Seeley No. 2
Tidal Company
Elev. T. D.
Log No. 9899 ?

soil 4
sh 35
ds 37
sh 100
ds 105
sh 215
ds 235
sh 310
ds 330
sh 470
ds 530
sh 625
ds 660
sh 780
ds 845
sh 940
ds 987
ds 1242
sh 1570
ds 1580
ds 1670
~~ds 1651~~
~~ds 1651~~
sh 1927
top ds 1927
dip showing 1950 pay 72
Bottom 1984

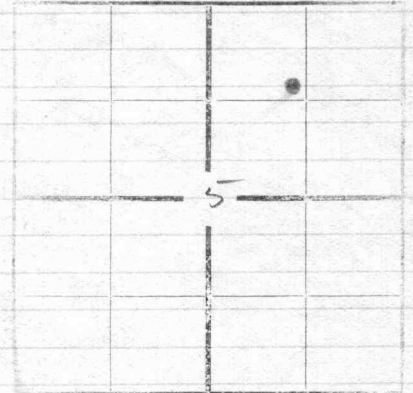

Com. Mar 10 '23
Comp Apr 4 '23.