

5-23-11E

GEOLOGICAL DEPARTMENT
SOUTHWESTERN GAS COMPANY

INDEPENDENCE, KANSAS

Gift of
W. L. Stryker Estate
State Geological Survey of Kansas
1970

LOG OF WELL

Company Tidal Oil Co. Farm Booley R.P. Well No. 3
 State Kansas County Greenwood S. 5 T. 23 R. 11
 Commenced Drilling 3-24-23 Completed 4-11-23 Elev. _____
 Shot _____ Qts. from _____ to _____ I. P. _____ R. P. _____
 Casing: 545' 1 1/2" Casing: 985' 10" Casing: 1665' 8 1/2"
 Casing: 1924' 6-5/8" Casing: _____ Casing: _____
 Tubing _____ Caged at _____ Packer at _____
 Contractor _____

soil 10
 clay 60
 slate 180
 shale & lime
 shell ~~640~~ 460
 shale 545
 slate 610
 lime 615
 slate 630
 lime 660
 slate lime shell
 725
 slate & sand 855 HPW
 sand & lime 1000
 slate 1050
 lime 1153
 slate 1265
 lime 1435
 slate 1565
 lime 1570
 slate 1580
 lime 1595
 shale 1660
 lime 1680
 shale 1924
 top sand 1994
 bottom 1994

5-23-11


#3

26978 12-545

comm - 3-24-23
conf - 4-11-23
prod - 100 bbls

10-985
8-1665
6-1924

5. 1994

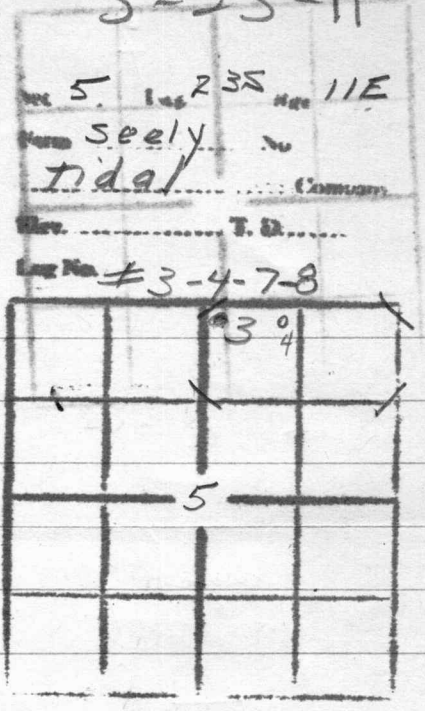

- surf 0-10
- cl 60
- sl 180
- shd shls 460
- sh 545
- sl 610
- L 615
- sl 630
- L 660
- shd shl 725
- sh & S 855 HFX
- S & L 985
- " " 1000
- sl 1050
- L 1133
- sl 1265
- L 1435
- sl 1565
- L 1570
- sl 1580
- L 1595
- sh 1660
- L 1680
- sh 1924

SLM - top sh 1924-94
Bottom 1994 5.

(over)