
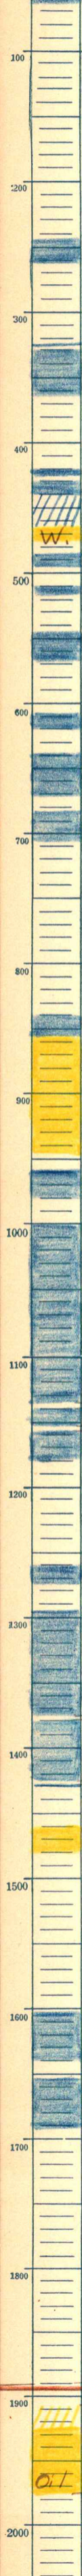


Kans. S. 5 T. 23 S., R. 11 E. W.
 Greenwood County
 White Eagle Company
 Seelye #2 Farm
 T.D.

350 gal.

Relation by
 drilled 10-25 to 11-17-22
 G.B.

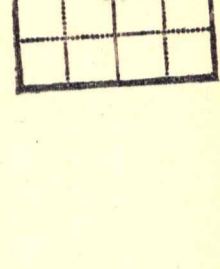

1460
 1480

1909
 1925
 1975

