


E  
W  
19  
S  
23  
5  
Township  
Section

Anderson  
County  
Goodel  
Farm  
No. 4  
Vionette Gas Co  
Company

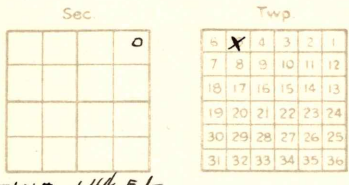

17' NE 14' E  
Elev. \_\_\_\_\_ T.D. 931  
Date Drilled Dec 8/28 - 1921  
Correlation by \_\_\_\_\_  
PRC 16 mil

