

Anderson _____
County
O'Hara _____ No. 1 _____
Farm
Limes Bros _____
Company

19
S
23
5
Range
Township
Section


Sec.

*			

Twp.

6	X	4	3	2	1
7	8	9	10	11	12
18	17	16	15	14	13
19	20	21	22	23	24
30	29	28	27	26	25
31	32	33	34	35	36

Elev. 1071 _____ T.D. 1012' _____
Date Drilled 5-4-21 _____
Correlation by _____

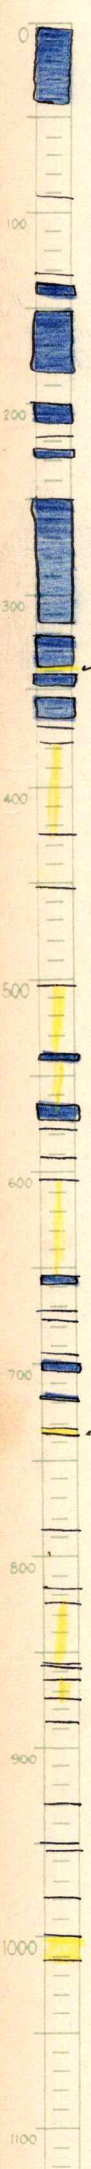

G.B.W.
H.F.W.

sd.

sd.

sd.

sd.

?

Gas

sd.

sd.
sh. oil-Gas.

Gas.
T.D. 1012'