


E #
19
23 S
6

Range
Township
Section


Anderson
County
Hendrix
Farm
Teton Synd.
Company
No. A

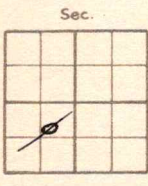

Twp.

6	5	4	3	2	1
7	8	9	10	11	12
18	17	16	15	14	13
19	20	21	22	23	24
30	29	28	27	26	25
31	32	33	34	35	36

Elev. 1078' T.D. 916'
Date Drilled _____
Correlation by _____

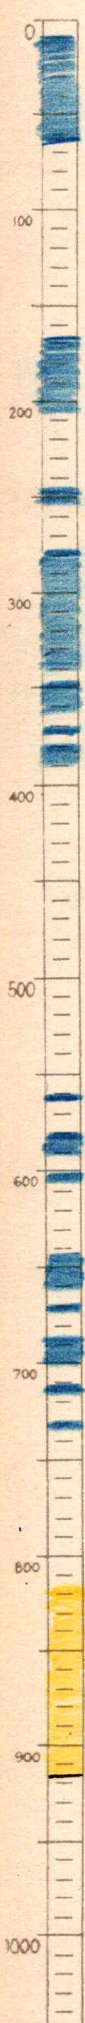

Gas

916' T.D.