
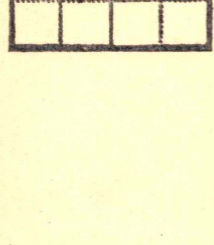


Kans. S. 7 T. 23 S., R. 11 E.   
 Greenwood County   
 Masland Company   
 J. R. Edwards #2 Farm   
 T.D.   
 Plat no 2 in SW SE 1/4   
 NW 1/4 -   
 Drilled 11/6 - 11/27/26   
 G.B.

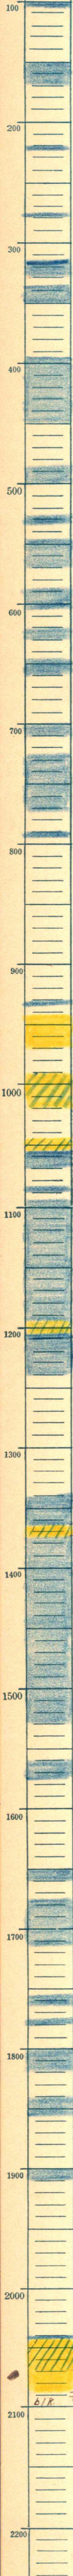

1365 2 B.W.   
 1375

1900-10

2040-43

2070

2089

2093

2094

Oil at 2075 increase at 2080-4

T.D. 2094'

2100

2200