

E
W
19
S
23
7

Anderson
Belvoir

County


No. 1

Farm

Company

Sec.

Twp.

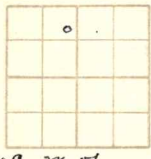

6	5	4	3	2	1
X	8	9	10	11	12
18	17	16	15	14	13
19	20	21	22	23	24
30	29	28	27	26	25
31	32	33	34	35	36

Loc. N of
CEL. NENW


Elev. _____

T.D. 964

Date Drilled _____

Correlation by _____

PRO 17. mil

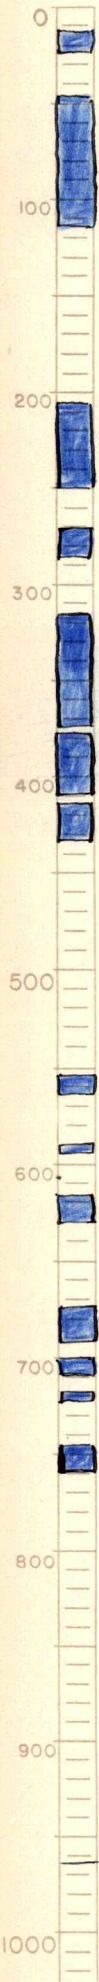

1st gas 870 ✱
2d " 885 ✱
B19. GAS 905 ✱
T D 964