

E
 19
 S
 23
 Township
 Range
 7
 Section

Anderson

County

Skourup


No. 4

Farm

Teton Synd.

Company

Sec.

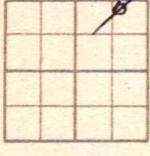


Twp.

6	5	4	3	2	1
7	8	9	10	11	12
18	17	16	15	14	13
19	20	21	22	23	24
30	29	28	27	26	25
31	32	33	34	35	36

Elev. 1131' T.D. 999'

Date Drilled 12-28-21

Correlation by

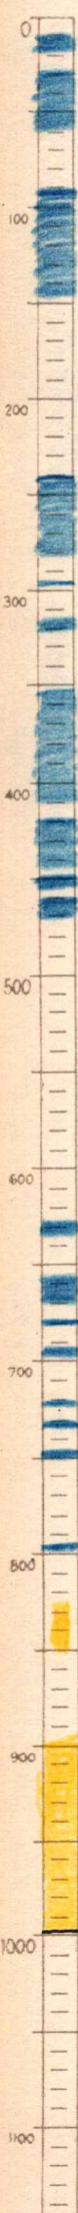

Gas

999' T.D.