


Holland # 3. Darby Oil.

13356

Drilling Commenced; April 4, 1923
 Drilling Completed; April 10, 1923

Sec. 8 Twp. 23 Rge. 11
 Farm Holland No. 3
 Darby Company
 Elev. T. D.
 Log No.

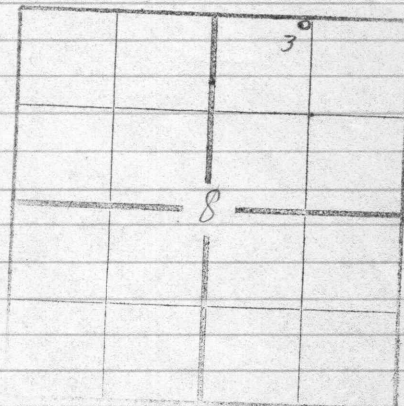

| | |
|------------------|-----------|
| soft Black soil | 10 |
| white lime | 14 |
| gray slate | 80 |
| slaty lime | 150 |
| lime | 170 |
| slate | 270 |
| lime | 288 |
| slate | 418 |
| lime | 434 |
| slate | 541 |
| lime | 551 |
| slate | 580 |
| lime | 640 |
| slate | 645 |
| lime | 655 |
| slate | 675 |
| lime | 687 |
| slate | 800 |
| lime | 805 |
| slate | 810 |
| sandy lime | water 950 |
| shale | 965 |
| lime | wtw 1100 |
| shale | 1236 |
| lime | 1400 |
| shale | 1410 |
| lime | 1510 |
| shale | 1522 |
| lime | 1550 |
| shale | 1700 |
| lime white | 1708 |
| shale | 1835 |
| lime black | 1843 |
| soft Black shale | 1898 |
| soft Brown sand | 1944 ≠ |

Casing Record

| | |
|--------|-------|
| 8 1/2" | 1528' |
| 6 5/8" | 1898' |