


Welland # 6

Sept 29, 1923 - October 20, 1923

Sec. 8 Twp. 23 Rge. 11
 Farm Welland No. 6
Garby Company
 Elev. f T. D. _____
 Log No. _____

Soil	5
Clay	10
slate	14
lime	17
slate	50
lime	70
slate	106
shale	120
Sandy shale	160
lime	180
slate	190
lime	200
shale	300
lime	340
shale	390
lime	420
shale	445
lime	495
shale	515
lime	535
plate	585
lime	595
slate	615
lime	665
slate	715
lime	720
slate	800
lime	805
shale	840
Water Sand	890
Plate	900
lime	905
Sand	945
Broken lime	955
slate	975
lime	995
shale	1015
lime	1065
lime	1075
lime	1125
Sandy shale	1245
lime	1300
lime	1315
sand	1325
lime	1355
shale	1366
shale	1368

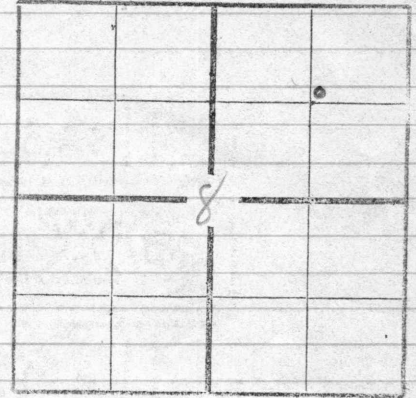

lime	1370
sand	1380
lime	1425
shale	1530
lime	1550
slate	1580
lime	1600

Casing Record

12 1/2	585'
10	975'
8 1/4	1550
6 3/8	