

Sec. 16 Twp. 23 Range 9E

#1 Teter

Kansas Geological Society

Empire

Skelly Scout Tickets

TESTER # I

Section 16 Twp. 23 Range 9

Greenwood County, Kansas.

Csg. Record:

Size	Set	Pulled
20"	12'	
15 1/2"	350'	350'
12 1/2"	965'	965'
10"	1575'	1575'
8 1/2"	2273'	
6 5/8"	2525'	2525'

Drig. commenced : April 24, 1919
 " completed : July 20, 1919
 Contractor: Ritchie & Atherton

FORMATION RECORD

FORMATION	COLOR	COND.	FROM	TO	REMARKS
Subsoil	dark	soft	10	10	
Lime	white	hard	10	30	
Slate blue	blue	soft	30	50	
Rock	red	soft	50	56	
Lime	white	hard	56	62	
Slate	blue	soft	62	130	
Lime	white	hard	130	140	
Slate	white	soft	140	160	
Lime	white	hard	160	180	
Slate	dark	soft	180	200	
Lime	white	hard	200	212	
Slate	blue	soft	212	230	
Lime	white	hard	230	242	
Slate	blue	soft	242	262	
Lime	white	hard	262	270	
Slate	blue	soft	270	298	
Lime	white	hard	298	330	
Mud	black	soft	330	348	
Lime	white	hard	348	358	
Slate	blue	soft	358	363	
Flint	blue	hard	363	368	
Lime	white	hard	368	400	
Slate	white	hard	400	435	
Lime	white	hard	435	465	
Rock	pink	soft	465	470	
Lime	white	hard	470	485	
Mud	blue	soft	485	500	
Slate	black	soft	500	520	
Lime	grey	hard	520	530	
Mud	black	soft	530	545	
Slate	white	soft	545	575	
Lime	yellow	soft	575	590	
Mud	black	soft	590	610	
Slate	black	hard	610	625	
Slate	black	soft	625	640	
Slate	black	hard	640	660	
Lime	yellow -	soft	660	667	
Slate	blue	soft	667	680	
Lime	white	hard	680	700	
Slate	blue	hard	700	725	
Lime	white	hard	725	740	
Shale	black	soft	740	760	
Slate	blue	soft	760	775	
Lime	white	hard	775	782	
Slate	white	soft	782	800	
Lime	yellow	soft	800	810	
Slate	white	soft	810	825	
Lime	white	hard	825	835	
Slate	black	hard	835	845	
Lime	black	hard	845	850	
Slate	black	soft	850	890	
Lime	white	hard	890	915	
Slate	white	soft	915	930	
Slate	black	hard	930	940	

Sheet 2.

FORMATION	COLOR	COND.	FROM	TO	REMARKS
Lime	white	hard	940	962	
Slate	white	soft	962	964	
Lime	white	hard	964	969	
Slate	black	soft	969	973	
Lime	white	hard	973	980	
Sand water			980	992	
Slate	black	soft	992	1002	
Lime	white	hard	1002	1012	
Slate	black	hard	1012	1027	
Lime	white	hard	1027	1037	
Lime	black	hard	1037	1045	
Lime	white	soft	1045	1055	4 blrs water at
Slate	white	soft	1055	1067	1055'
Lime	black	hard	1067	1073	
Slate	blue	soft	1073	1080	
Lime	white	soft	1080	1085	
Slate	black	soft	1085	1092	
Lime	white	soft	1092	1097	
Lime	black	hard	1097	1107	
Slate	black	soft	1107	1112	
Lime	white	soft	1112	1120	
Slate	white	soft	1120	1125	
Lime	white	hard	1125	1145	
Slate	black	soft	1145	1160	
Slate	white p	soft	1160	1175	5 blrs water at
Mud	blue	soft	1175	1220	1175'
Lime	white	hard	1220	1227	
Slate	blue	soft	1227	1235	
Lime	white	hard	1235	1275	
Slate	white	soft	1275	1280	
Lime	white	hard	1280	1300	
Lime	white	hard	1300	1315	
Slate	blue	soft	1315	1400	
Slate	white	hard	1400	1412	
Water sand	white	soft	1412	1430	
Slate	blue	soft	1430	1435	
Sand	white	hard	1435	1448	
Slate	white	soft	1448	1454	
Lime	white	hard	1454	1459	
Slate	white	soft	1459	1463	
Lime	white	soft	1463	1470	Water
Water sand	"	"	1470	1511	
Slate	Green	soft	1511	1513	
Sand	white	soft	1513	1550	
Slate	white	soft	1550	1565	
Lime	white	soft	1565	1573	
Lime	blue	hard	1573	1583	
Lime	white	hard	1583	1650	
Slate	white	soft	1650	1652	
Lime	white	hard	1652	1662	
Lime	white	soft	1662	1673	
Lime	brown	hard	1673	1680	
Lime	white	soft	1680	1701	
Lime	"	hard	1701	1706	
Lime	"	soft	1706	1726	
Slate	white	soft	1726	1830	
Lime	white	hard	1830	1872	
Slate	black	soft	1872	1883	
Lime	white	hard	1883	1930	4 blrs water at
Lime	white	soft	1930	1945	1895'
Slate	white	soft	1945	1960	
Lime	white	hard	1960	1968	
Slate	black	soft	1968	1974	
Lime	white	hard	1974	1979	
Shale	black	soft	1979	1985	
Shale	white	soft	1985	1997	

TEETER I

Sheet 3.

FORMATION	COLOR	COND.	FROM	TO	REMARKS
Lime	white	hard	1996	2015	
Lime	white	soft	2015	2034	
Shale	blue	soft	2034	2059	
Slate	white	soft	2059	2074	
Shale	white	soft	2074	2090	
Lime	white	hard	2090	2200	
Slate	white	soft	2200	2270	
Lime	white	hard	2270	2275	
Slate	white	soft	2275	2300	
Lime	white	soft hard	2300	2305	
Slate	white	soft	2305	2388	
Lime	white	hard	2388	2393	
Slate	brown	soft	2393	2428	
Slate	white	soft	2428	2448	
Slate	brown	soft	2448	2463	
Slate	white	soft	2463	2480	Cave at 2470'
Sand	white	soft	2480	2510	
Slate	white	grit	2510	2520	
Sand	white	soft	2520	2530	
				2540	O11
				2545	T.D.

CLASS OF SERVICE	SYMBOL
Day Message	
Day Letter	Blue
Night Message	Nite
Night Letter	N L

If none of these three symbols appears after the check (number of words) this is a day message. Otherwise its character is indicated by the symbol appearing after the check.

WESTERN UNION TELEGRAM

NEWCOMB CARLTON, PRESIDENT

GEORGE W. E. ATKINS, FIRST VICE-PRESIDENT

CLASS OF SERVICE	SYMBOL
Day Message	
Day Letter	Blue
Night Message	Nite
Night Letter	N L

If none of these three symbols appears after the check (number of words) this is a day message. Otherwise its character is indicated by the symbol appearing after the check.

RECEIVED AT 104 EAST 3D ST., TULSA, OKLA.

J131KM 41

WICHITA: KANS 1120A 18

H L LAWLER

534


SCOUTING DEPT COSDEN OIL AND GAS CO TULSA OKLA

EMPIRE TETER SIXTEEN TWENTY THREE NINE HAVE SHOWING FOR SMALL WELL
UNABLE TO GET ACCURATE DOPE AS NO ONE IS ALLOWED IN RIG SAND
SUPPOSED TO BE TWENTY FIVE TWENTY TO FORTY EIGHT ENDEAVORING TO
SHOOT SQUIB SHOT OFF IN CASING

H B. PYLE.

1919 JUL 18 PM 12 21

Map No. _____ Sec. 16 Twp. 23 R. 9
 Well No. 1 Jeter Farm _____
Empire Company _____

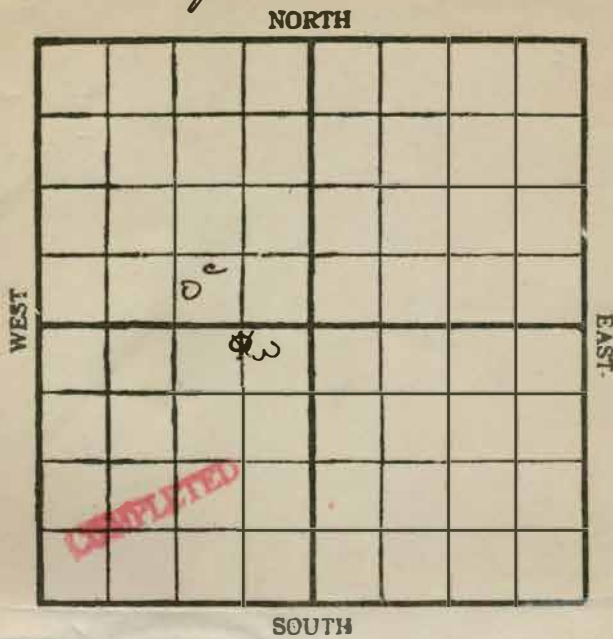

Location _____

Rig Up _____

Drilling Remarks:

Drilling Remarks:

Shot 40 gals
52 1/2 bbls.
1st 9 hrs.
pumped off

RECORD


Cased _____ in. _____ ft.
 Sand 2486-2548
 Gas _____
 Oil 2520-2548
 Total Depth _____

PRODUCTION

1st 24 hrs. Nat. _____
 1st 24 hrs. after shot _____
 Gas _____ cu.
 Dry Hole _____
 Abandoned _____

Map No. K15 Sec. 16 Twp. 23 R. 9Well No. 1 WaterCompany Empire

Contractor

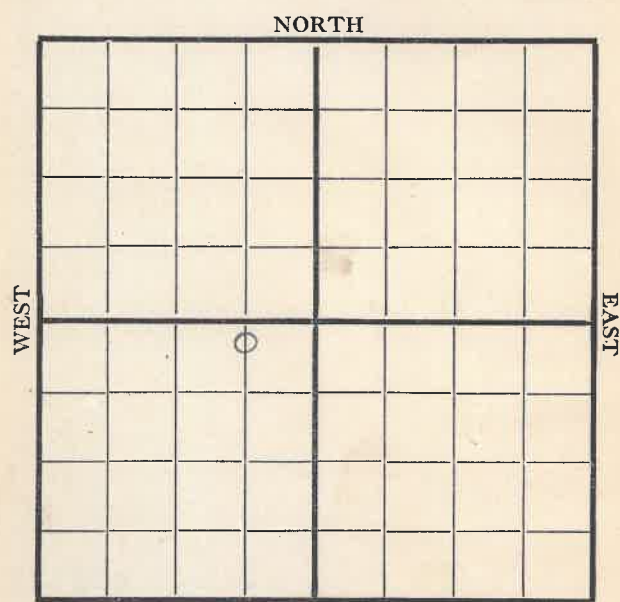

660 E SOUTH 200 N

Location

Rig up ☒

Drilling and Remarks:

Cased _____ in., _____ ft.

Sand _____

Gas _____

Oil _____

Total Depth _____

PRODUCTION

1st 24 hrs. Nat. _____

1st 24 hrs. after shot _____

Gas _____ Cu. Ft.

Dry Hole _____


Abandoned _____

Date

4/11 1919 Pyle Scout

Map No. K15 Sec. 16 Twp. 23 R. 9Well No. 1 WaterCompany Empire

Contractor

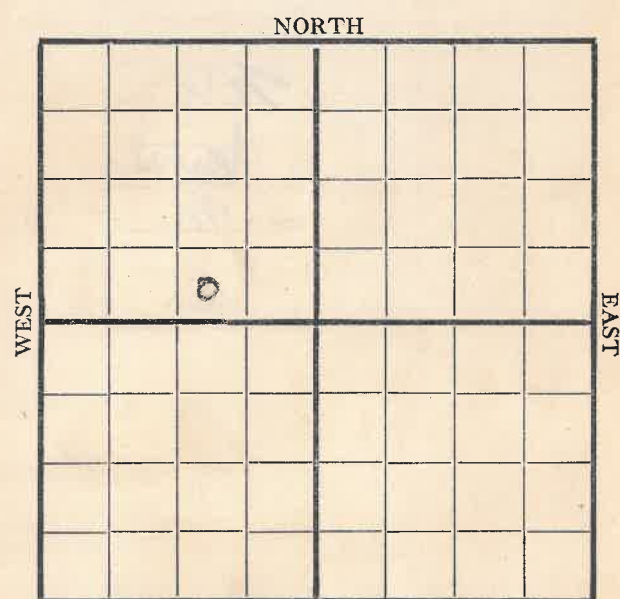

990 E SOUTH 330 S

Location

Rig up

Drilling and Remarks:

Shot 40 gts

Supposed to
be pumping.
200 bls

Cased _____ in., _____ ft.

Sand 2486-2549

Gas _____

Oil 2520-2548

Total Depth _____

PRODUCTION

1st 24 hrs. Nat. _____

1st 24 hrs. after shot _____

Gas _____ Cu. Ft.

Dry Hole _____


Abandoned _____

Date

8/2 1919 Pyle Scout

Map No. K15 Sec. 16 Twp. 23 R. 9Well No. 1 WaterCompany Empire

Contractor

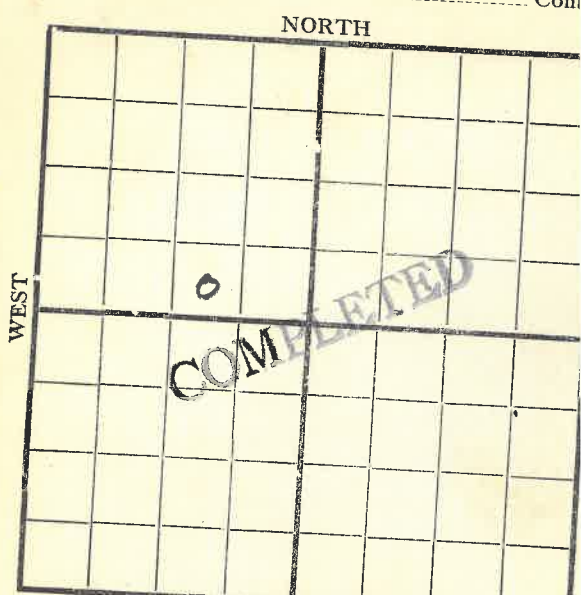

990 E SOUTH 330 S

Location

Rig up

Drilling and Remarks:

Shot 40 gts
52 1/2 bls
1st 9 hours
pumped off.

Cased _____ in., _____ ft.

Sand 2486-2548

Gas _____

Oil 2520-2548

Total Depth _____

PRODUCTION

1st 24 hrs. Nat. _____

1st 24 hrs. after shot _____

Gas _____ Cu. Ft.

Dry Hole _____


Abandoned _____

Date

7/9 1919 Pyle Scout

Map No. K15 Sec. 16 Twp. 23 R. 9Well No. 1 WaterCompany Empire

Contractor

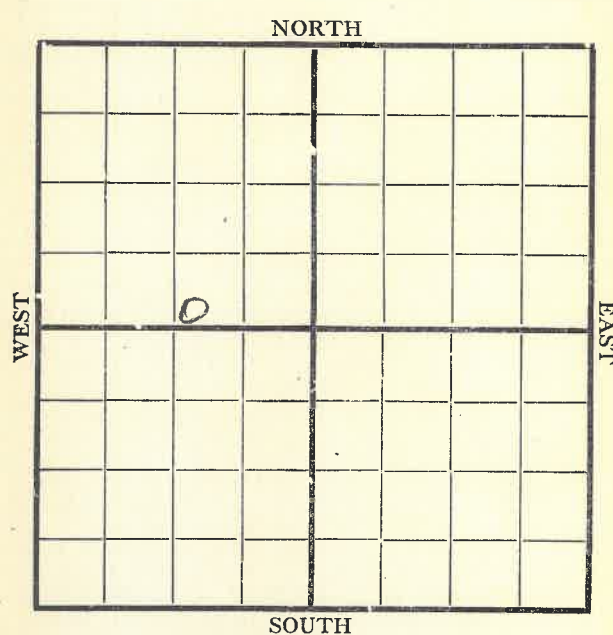

SOUTH

Location

Rig up

Drilling and Remarks:

D. 10 @
400'

Cased _____ in., _____ ft.

Sand _____

Gas _____

Oil _____

Total Depth _____

PRODUCTION

1st 24 hrs. Nat. _____

1st 24 hrs. after shot _____

Gas _____ Cu. Ft.

Dry Hole _____


Abandoned _____

Date

5/7 1919 Pyle Scout

Map No. K15 Sec. 16 Twp. 23 R. 9Well No. 1 WaterCompany Empire

Contractor

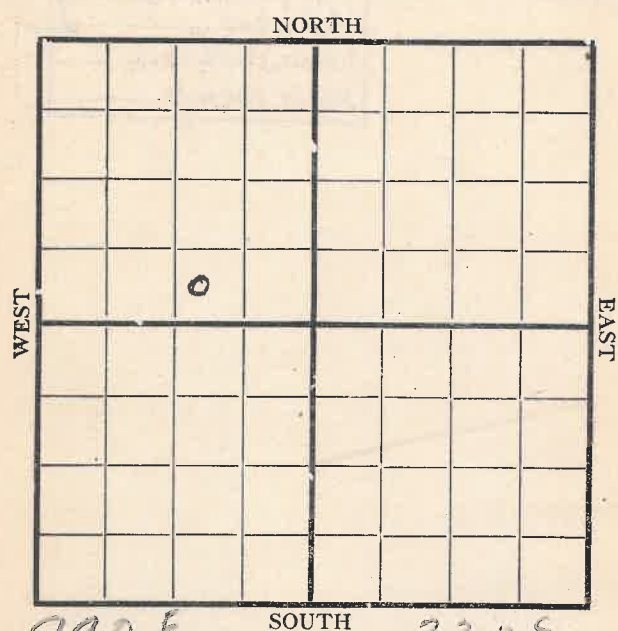

990 E SOUTH 330 S

Location

Rig up ☒

Drilling and Remarks:

Change
location
of first
report

Cased _____ in., _____ ft.

Sand _____

Gas _____

Oil _____

Total Depth _____

PRODUCTION

1st 24 hrs. Nat. _____

1st 24 hrs. after shot _____

Gas _____ Cu. Ft.

Dry Hole _____


Abandoned _____

Date

4/18 1919 Pyle Scout

Map No. K15 Sec. 16 Twp. 23 R. 9Well No. 1 WaterCompany Empire

Contractor

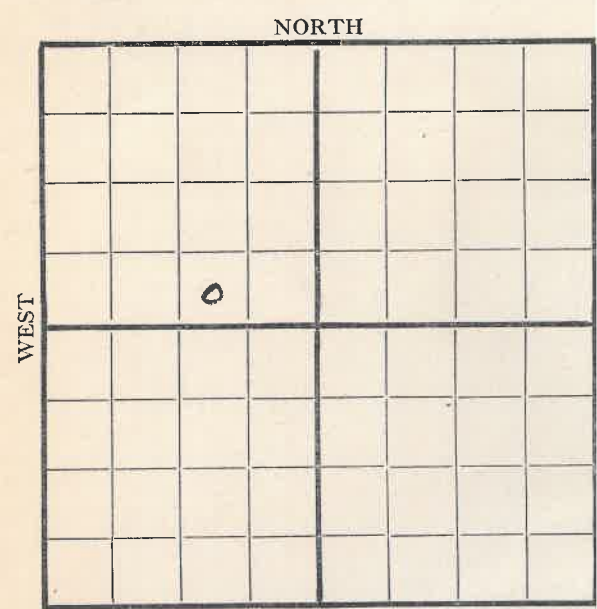

990 E SOUTH 330 S

Location

Rig up ☒

Drilling and Remarks:

Cased _____ in., _____ ft.

Sand _____

Gas _____

Oil _____

Total Depth _____

PRODUCTION

1st 24 hrs. Nat. _____

1st 24 hrs. after shot _____

Gas _____ Cu. Ft.


Dry Hole _____

Abandoned _____

Date

4/24 1919 Pyle Scout

Map No. K15 Sec. 16 Twp. 23 R. 9
Well No. 1 Jeter
Empire Company
Contractor

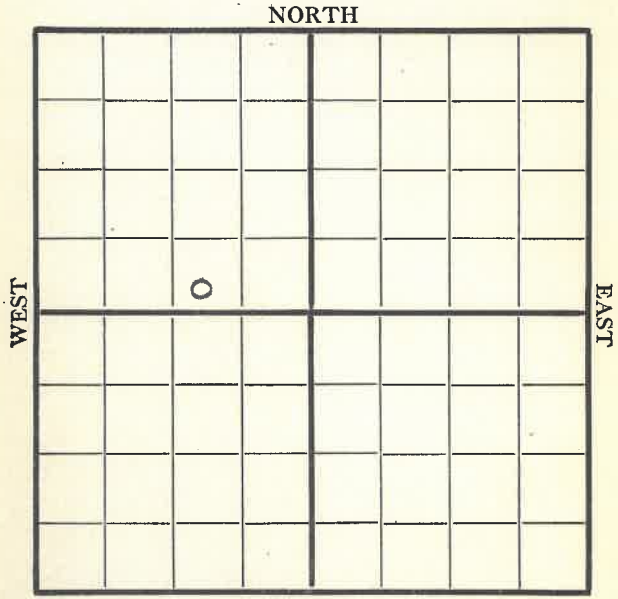


200' D - 11205

Location _____ Rig up _____ Drilling and Remarks: _____	RECORD	
	Cased _____ in., _____ ft.	
	Sand _____	
	Gas _____	
	Oil _____	
	Total Depth _____	
	PRODUCTION	
	1st 24 hrs. Nat. _____	
	1st 24 hrs. after shot _____	
	Gas _____	Cu. Ft. _____
	Dry Hole _____	
	Abandoned _____	

Date 5/17 1919 Pyle Scout

Map No. K15 Sec. 16 Twp. 23 R. 9
Well No. 1 Jeter
Empire Company
Contractor

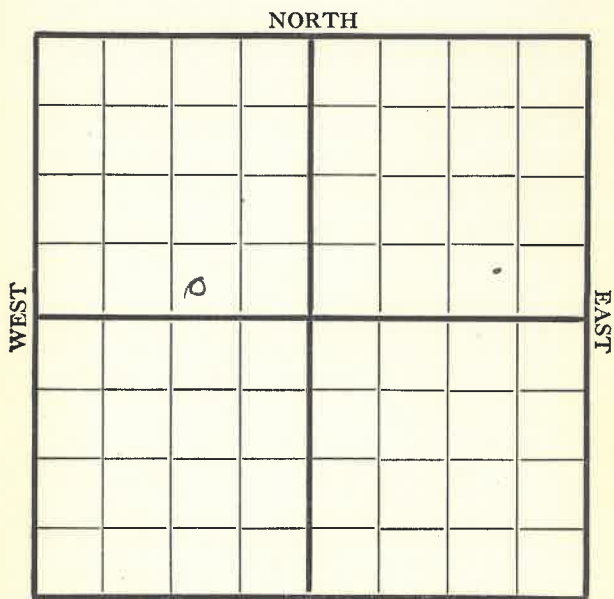


990 E 330 S

Location _____ Rig up _____ Drilling and Remarks: _____	RECORD	
	Cased _____ in., _____ ft.	
	Sand _____	
	Gas _____	
	Oil _____	
	Total Depth _____	
	PRODUCTION	
	1st 24 hrs. Nat. _____	
	1st 24 hrs. after shot _____	
	Gas _____	Cu. Ft. _____
	Dry Hole _____	
	Abandoned _____	

Date 5/25 1919 Pyle Scout

Map No. K15 Sec. 16 Twp. 23 R. 9
Well No. 1 Jeter
Empire Company
Contractor

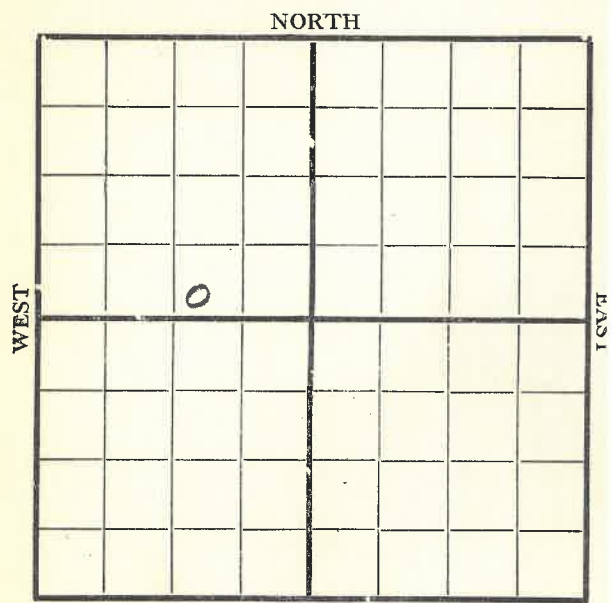


990 E 330 S

Location _____ Rig up _____ Drilling and Remarks: _____	RECORD	
	Cased _____ in., _____ ft.	
	Sand _____	
	Gas _____	
	Oil _____	
	Total Depth _____	
	PRODUCTION	
	1st 24 hrs. Nat. _____	
	1st 24 hrs. after shot _____	
	Gas _____	Cu. Ft. _____
	Dry Hole _____	
	Abandoned _____	

Date 5/29 1919 Pyle Scout

Map No. K15 Sec. 16 Twp. 23 R. 9
Well No. 1 Jeter
Empire Company
Contractor

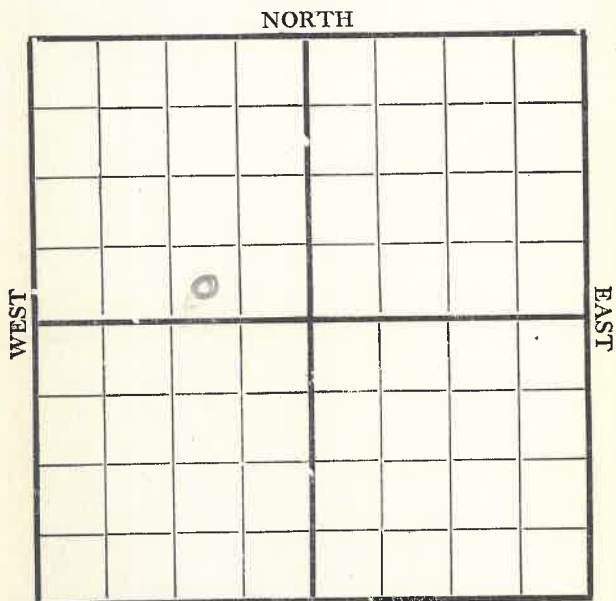


990 E 330 S

Location _____ Rig up _____ Drilling and Remarks: _____	RECORD	
	Cased _____ in., _____ ft.	
	Sand _____	
	Gas _____	
	Oil _____	
	Total Depth _____	
	PRODUCTION	
	1st 24 hrs. Nat. _____	
	1st 24 hrs. after shot _____	
	Gas _____	Cu. Ft. _____
	Dry Hole _____	
	Abandoned _____	

Date 6/5 1919 Pyle Scout

Map No. K15 Sec. 16 Twp. 23 R. 9
Well No. 1 Jeter
Empire Company
Contractor

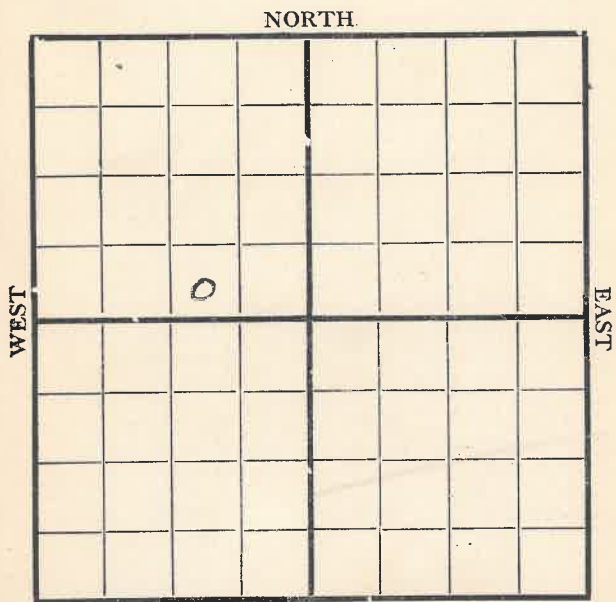


990 E 330 S

Location _____ Rig up _____ Drilling and Remarks: _____	RECORD	
	Cased _____ in., _____ ft.	
	Sand _____	
	Gas _____	
	Oil _____	
	Total Depth _____	
	PRODUCTION	
	1st 24 hrs. Nat. _____	
	1st 24 hrs. after shot _____	
	Gas _____	Cu. Ft. _____
	Dry Hole _____	
	Abandoned _____	

Date 6/20 1919 Pyle Scout

Map No. K15 Sec. 16 Twp. 23 R. 9
Well No. 1 Jeter
Empire Company
Contractor

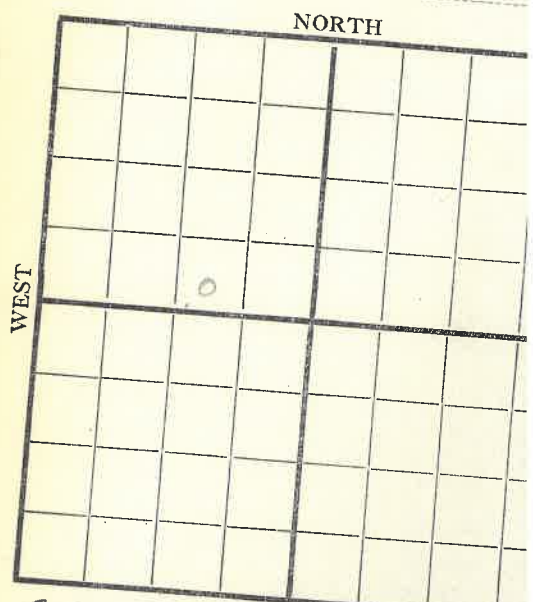


990 E 330 S

Location _____ Rig up _____ Drilling and Remarks: _____	RECORD	
	Cased _____ in., _____ ft.	
	Sand _____	
	Gas _____	
	Oil _____	
	Total Depth _____	
	PRODUCTION	
	1st 24 hrs. Nat. _____	
	1st 24 hrs. after shot _____	
	Gas _____	Cu. Ft. _____
	Dry Hole _____	
	Abandoned _____	

Date 6/11 1919 Pyle Scout

Map No. K15 Sec. 16 Twp. 23 R. 9
Well No. 1 Jeter
Empire Company
Contractor

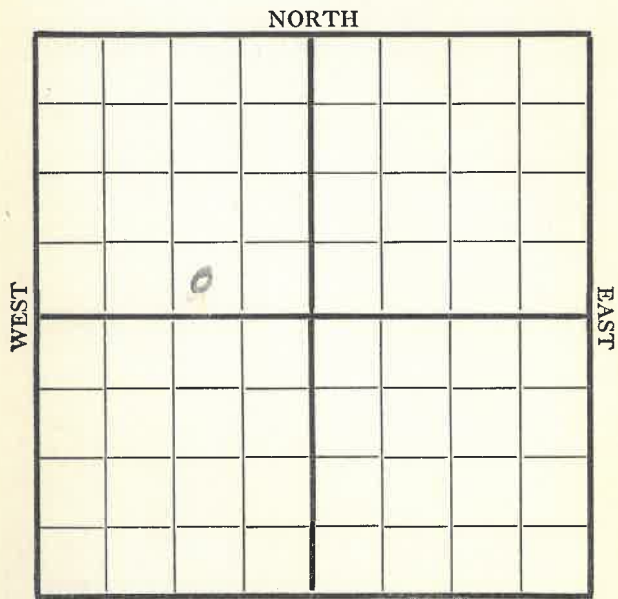

990 E SOUTH 330 S


Location _____
Rig up _____
Drilling and Remarks:

RECORD
Cased _____ in., _____ ft.
Sand _____
Gas _____
Oil _____
Total Depth _____

PRODUCTION
1st 24 hrs. Nat. _____
1st 24 hrs. after shot _____
Gas _____ Cu. Ft.
Dry Hole _____
Abandoned _____

Date 6/28 1919 Cycle Scout

Map No. K15 Sec. 16 Twp. 23 R. 9
Well No. 1 Jeter
Empire Company
Contractor

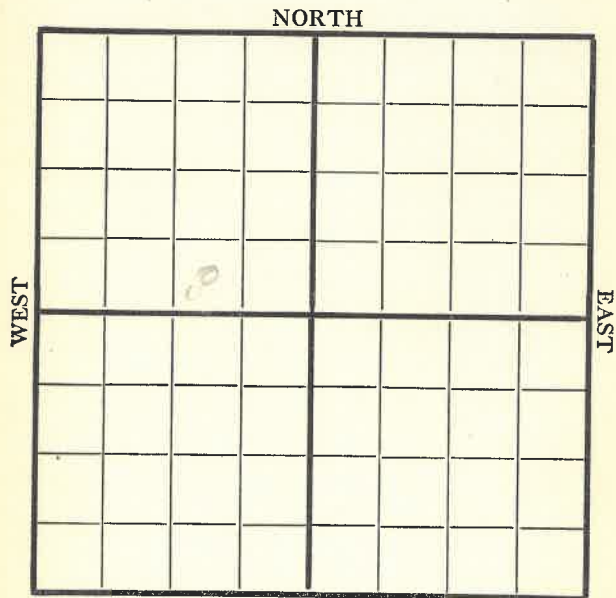

990 E SOUTH 330 S


Location _____
Rig up _____
Drilling and Remarks:

RECORD
Cased _____ in., _____ ft.
Sand _____
Gas _____
Oil _____
Total Depth _____

PRODUCTION
1st 24 hrs. Nat. _____
1st 24 hrs. after shot _____
Gas _____ Cu. Ft.
Dry Hole _____
Abandoned _____

Date 7/12 1919 Cycle Scout

Map No. K15 Sec. 16 Twp. 23 R. 9
Well No. 1 Jeter
Empire Company
Contractor

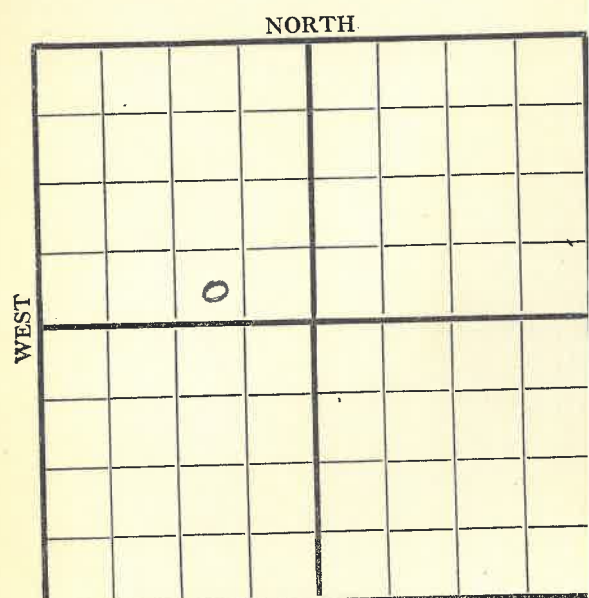

330 S SOUTH 990 E


Location _____
Rig up _____
Drilling and Remarks:

RECORD
Cased _____ in., _____ ft.
Sand _____
Gas _____
Oil _____
Total Depth _____

PRODUCTION
1st 24 hrs. Nat. _____
1st 24 hrs. after shot _____
Gas _____ Cu. Ft.
Dry Hole _____
Abandoned _____

Date 7/6 1919 Cycle Scout

Map No. K15 Sec. 16 Twp. 23 R. 9
Well No. 1 Jeter
Empire Company
Contractor

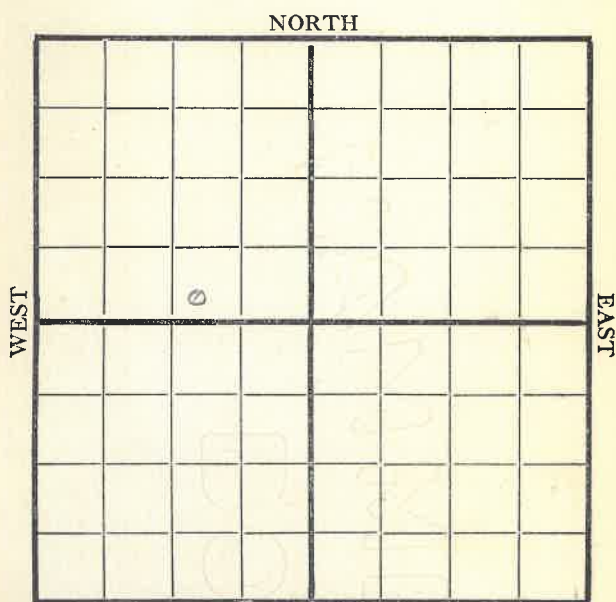

990 E SOUTH 330 S


Location _____
Rig up _____
Drilling and Remarks:

RECORD
Cased _____ in., _____ ft.
Sand 2486 - 2548
Gas _____
Oil 2520 - 2548
Total Depth _____

PRODUCTION
1st 24 hrs. Nat. _____
1st 24 hrs. after shot _____
Gas _____ Cu. Ft.
Dry Hole _____
Abandoned _____

Date 7/23 1919 Cycle Scout

Map No. K15 Sec. 16 Twp. 23 R. 9
Well No. 1 Jeter
Empire Company
Contractor

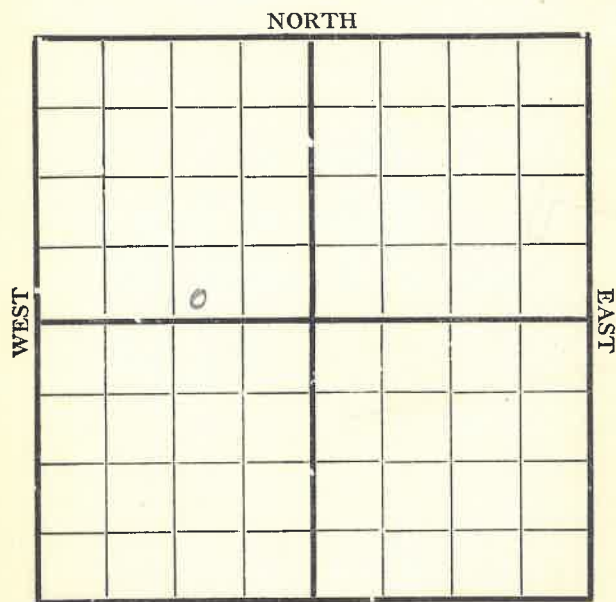

990 E SOUTH 330 S


Location _____
Rig up _____
Drilling and Remarks:

RECORD
Cased _____ in., _____ ft.
Sand _____
Gas _____
Oil 2520 - 2548
Total Depth _____

PRODUCTION
1st 24 hrs. Nat. _____
1st 24 hrs. after shot _____
Gas _____ Cu. Ft.
Dry Hole _____
Abandoned _____

Date 7/18 1919 Cycle Scout

Map No. K15 Sec. 16 Twp. 23 R. 9
Well No. 1 Jeter
Empire N. & F. Company

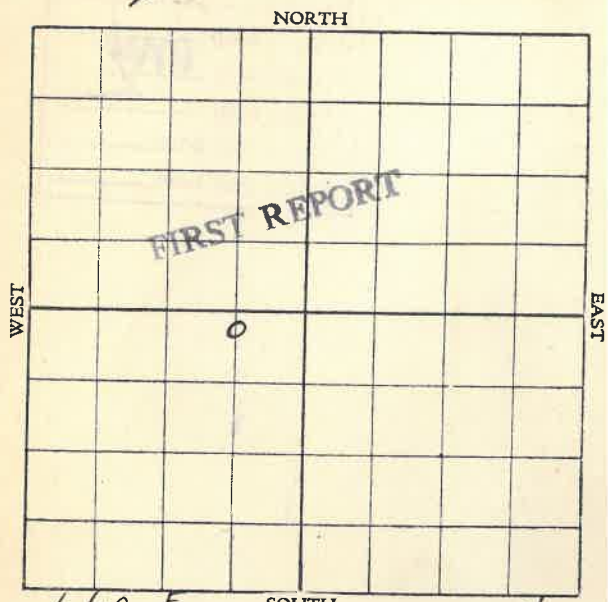

660 E. SOUTH 200 N

Location _____
Rig up ☒
Drilling and remarks:

RECORD
Cased _____ in., _____ ft.
Sand _____
Gas _____
Oil _____
Total Depth _____

PRODUCTION
1st 24 hrs. Nat. _____
1st 24 hrs. after shot _____
Gas _____ Cu. Ft.
Dry Hole _____
Abandoned _____

Date April 4 1919 Cycle Scout