




Map No. K 15 Sec. 16 Twp. 23 R. 9  
 Well No. 2 Peeters Farm  
Empire Company  
 Date Started \_\_\_\_\_ Ft. from N 230 S. 960 W. line  
 NORTH

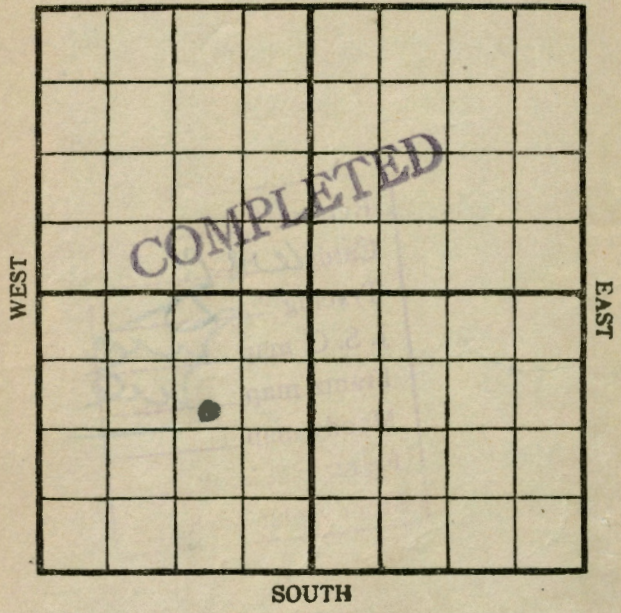

Cased \_\_\_\_\_ In. \_\_\_\_\_ Ft.  
 Sand 2497-2543  
 Pay { Gas \_\_\_\_\_  
 Oil \_\_\_\_\_  
 Total Depth \_\_\_\_\_


Production Remarks  
1st 24 hrs 40 bbls

Condition of Well on this date \_\_\_\_\_

4/10 **Pyle** Scout

Map No. K 15 Sec. 16 Twp. 23 R. 9  
 Well No. 2 Peeters Farm  
Empire Company  
 Contractor \_\_\_\_\_

1230 Ft. from N. Line  
 \_\_\_\_\_ Ft. from S. Line  
960 Ft. from E. Line  
 \_\_\_\_\_ Ft. from W. Line

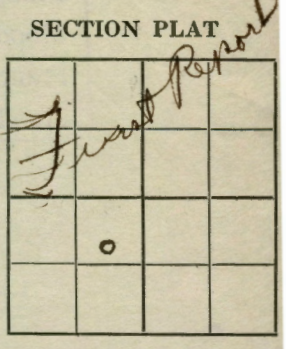

Location \_\_\_\_\_  
 Rig up \_\_\_\_\_  
 Drilling and Remarks:

J.O.M

RECORD  
 Cased \_\_\_\_\_ in., \_\_\_\_\_ ft.  
 Sand \_\_\_\_\_  
 Gas \_\_\_\_\_  
 Oil \_\_\_\_\_  
 Total Depth \_\_\_\_\_

PRODUCTION  
 1st 24 hrs. Nat. \_\_\_\_\_  
 1st 24 hrs. after shot \_\_\_\_\_  
 Gas \_\_\_\_\_ Cu. Ft.  
 Dry Hole \_\_\_\_\_  
 Abandoned \_\_\_\_\_

Date 9/4 1919 **Pyle** Scout

Map No. *K15* Sec. *16* Twp. *23* R. *9*

Well No. *2 Feeters*

*Empire* Company

Contractor

SECTION PLAT

*1230* Ft. from N. Line

Ft. from S. Line

*960* Ft. from E. Line

Ft. from W. Line


FIRST REPORT

Location

Rig up

Drilling and Remarks:

*Timbers*

RECORD

Cased in, ft.

Sand

Gas

Oil

Total Depth

PRODUCTION

1st 24 hrs. Nat.

1st 24 hrs. after shot

Gas Cu. Ft.

Dry Hole

Abandoned

Date

*8/20* 191*9*

**Pyle**

Scout