


Map No. Kansas Sec. 4 Twp. 23 R. 9Well No. 2 moller FarmTom Conway Company

NORTH

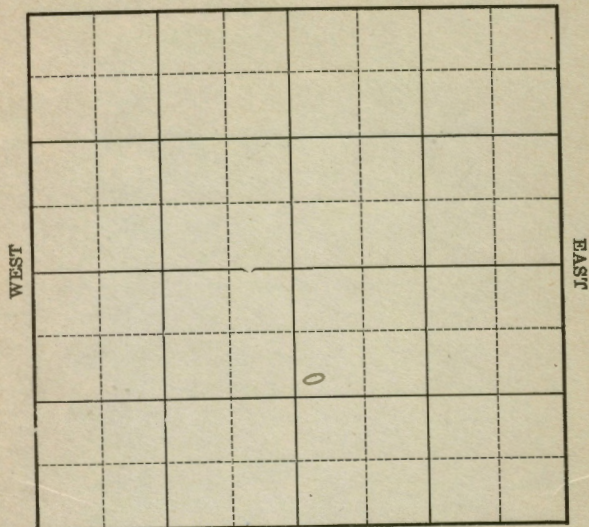

SOUTH

Location _____
Drilling Remarks _____Rig Up _____
Drilling Remarks _____

RECORD

Cased _____ in. _____ ft.
Sand _____
Gas _____
Oil _____
Total Depth _____

PRODUCTION


1st 24 hrs. Nat. _____
1st 24 hrs. after shot _____
Gas _____ cu. ft.
Dry Hole _____
Abandoned _____Map No. Kansas Sec. 4 Twp. 23 R. 9Well No. 2 moller FarmTom Conway Company

NORTH

990 Ft. from N. Line

_____ Ft. from S. Line

_____ Ft. from E. Line

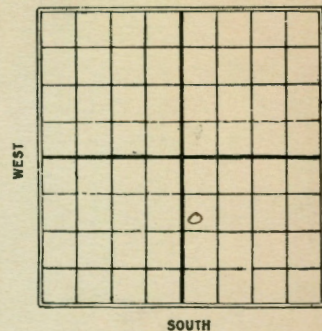330 Ft. from W. Line

SOUTH

Date

REPORT

19263/25 Location5/28 Same5/19 _____6/2 _____6/10 _____6/18 _____6/25 _____6-30 _____7/8 _____7/14 Abandoned location

K15 KANSAS

Map No. Sec. 4 Twp. 23 R. 9

Well No. 2

Jom Conway Company

Contractor

COMPLETED

SECTION PLAT

990 Ft. from N. Line

Ft. from S. Line

Ft. from E. Line

330 Ft. from W. Line

ABANDONED

Location

Rig up

Drilling and Remarks:

RECORD

Cased in., ft.

Sand

Gas

Oil

Total Depth

PRODUCTION

1st 24 hrs. Nat.

1st 24 hrs. after shot

Gas Cu. Ft.

Dry Hole

Abandoned

Date

JUL 14 1926

192

CHAS. L. SHERWOOD

Scout

K15 KANSAS

Map No. Sec. 4 Twp. 23 R. 9

Well No. 2

Jom Conway Company

Contractor

FIRST REPORTS

SECTION PLAT

990 Ft. from N. Line

Ft. from S. Line

Ft. from E. Line

330 Ft. from W. Line

Location

Rig up

Drilling and Remarks:

RECORD

Cased in., ft.

Sand

Gas

Oil

Total Depth

PRODUCTION

1st 24 hrs. Nat.

1st 24 hrs. after shot

Gas Cu. Ft.

Dry Hole

Abandoned

Date

MAR 25 1926

192

CHAS. L. SHERWOOD

Scout